

Name Moore Homes Inc.

Service No.

Address 7 Frost Road

Lot #6

Location

Kind of Pipe

Size

Size of Main

Repair—Renewal—New Service

DeFlice Bros Permit #A300

Location


| Date    |     | Material         | Amount |  | Total |  | Date |  | Amount |  |
|---------|-----|------------------|--------|--|-------|--|------|--|--------|--|
| 5/23/66 | 40' | 6" Transite pipe |        |  |       |  |      |  |        |  |
|         | 10' | Cast Iron Pipe   |        |  |       |  |      |  |        |  |
|         |     |                  |        |  |       |  |      |  |        |  |
|         |     |                  |        |  |       |  |      |  |        |  |
DATE \_\_\_\_\_

TOWN OF LEXINGTON — BOARD OF PUBLIC WORKS

SEWER DIVISION

7 Sketch of Service Here

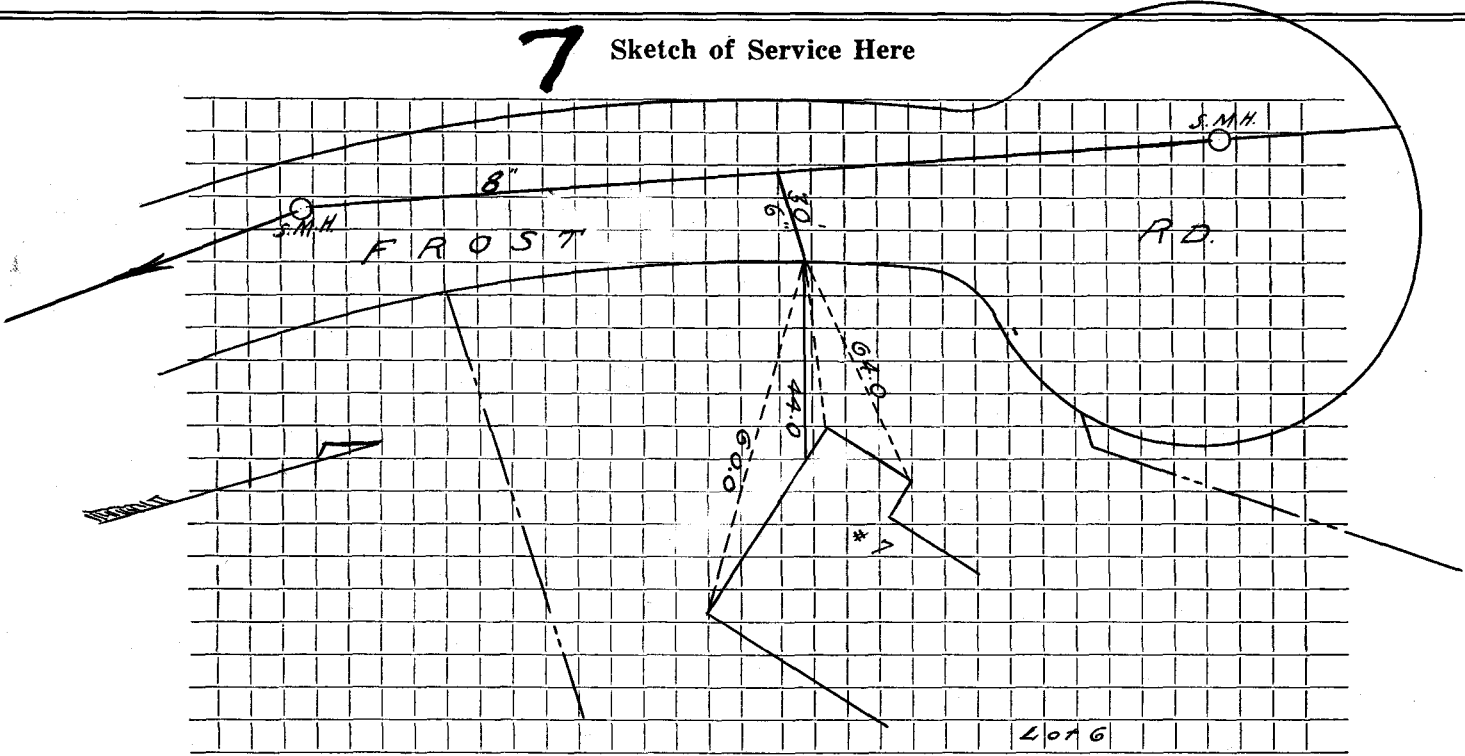

Connection made in ..... Street. Work completed .....

Remarks: .....  
.....  
.....