

Name Moore Realty Trust

Service No.

Address 9 Frost Road

Lot #5

Location

Kind of Pipe

Size

Size of Main

~~Repair Renewal~~ - New Service DeFlice Bros. - Permit #19

Location


Date		Material	Amount		Total		Date		Amount	
1964	35'	6" Transite pipe								

DATE _____

TOWN OF LEXINGTON — BOARD OF PUBLIC WORKS

SEWER DIVISION

Sketch of Service Here **9**

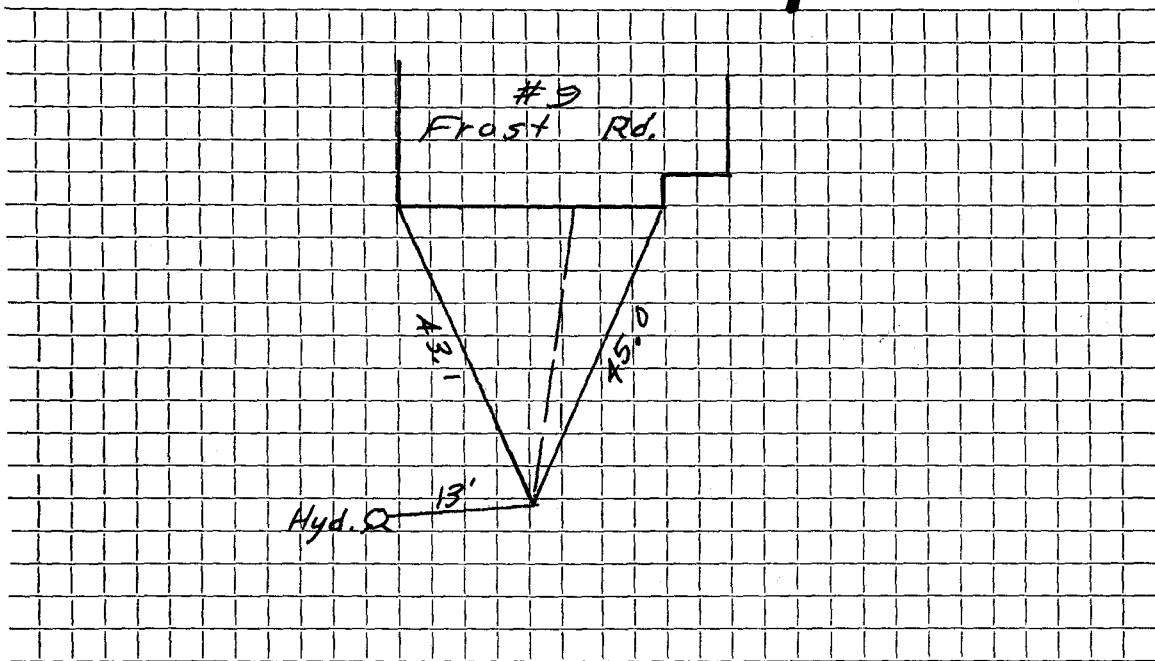

Connection made in Street. Work completed

Remarks:
.....
.....