

Name Mark Moore, Jr.

Service No. 78

Address 31 Fuller Road

Location

Kind of Pipe

Size

Size of Main

~~REMARKS~~ New Service

COM. 7-19-54

Location

Date	Material	Amount	Total	Date	Amount
6/11/54	Labor	57 64		5-19-54	Deposited 175 00
	10% overhead	5 76	63 40	7-20-54	Refunded 64 26
	44' - 6" sewer pipe @ .30		13 20		<u>NON CHARGE</u> 110 74
	joint compound		2 64	60' - 6" sewer pipe @ .30	18 00
	4 hrs. Littlefield shovel @ 7.50	7.50	30 00	joint compound	3 60
	2 hrs. trucking @ .75		1 50	4 hrs. Littlefield shovel @ 7.50	30 00
			110 74	2 hrs. trucking @ .75	1 50
					53 10
				6-5-86 = SERVICE CAN BE FLUSHED WITH MYERS MANHOLE ACROSS ST IN INTERSECTION OF DEXTER RD. SERVICE BLOCHED ABOUT 60' IN FROM MANHOLE	
	Labor				

TOWN OF LEXINGTON—DEPT. OF PUBLIC WORKS

SEWER DIVISION

DATE.....

NO.


The undersigned applies for the construction of a particular sewer connecting No.....
 Street and hereby agrees to comply with the Rules and Regulations governing the construction and use of Particular
 Sewers, as now or at any future time established by the Board of Selectmen.

Am't of estimate \$.....

Am't Paid \$.....

..... Owner

Sketch of Service Here

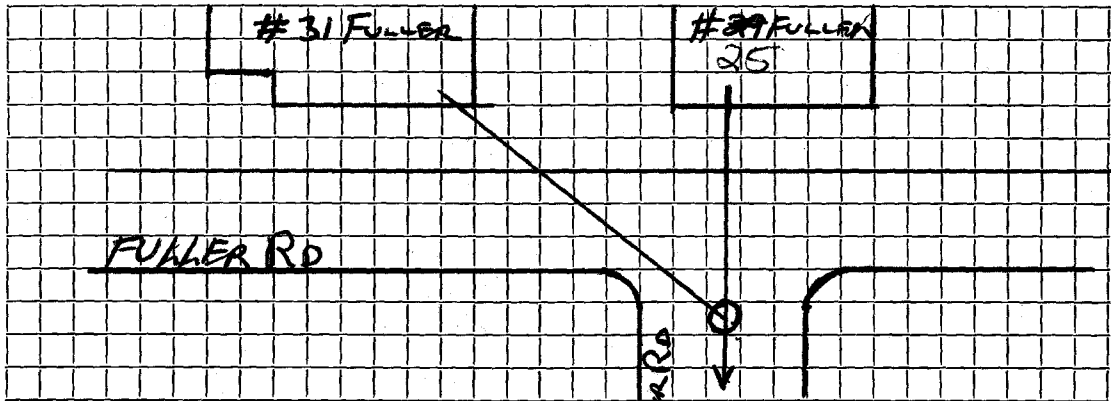

Connection made in..... Street.

Work completed.....19..

Remarks:

DEXTER RD