



TOWN OF LEXINGTON—DEPT. OF PUBLIC WORKS  
**SEWER DIVISION**

DATE .....

NO. ....

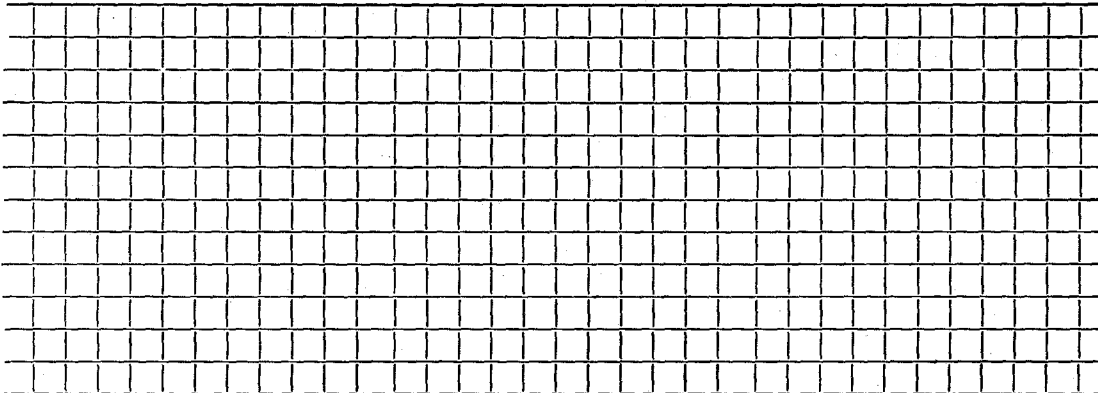
The undersigned applies for the construction of a particular sewer connecting No. ....  
Street and hereby agrees to comply with the Rules and Regulations governing the construction and use of Particular  
Sewers, as now or at any future time established by the Board of Selectmen.

Am't of estimate \$. ....

Am't Paid \$. ....

..... Owner

**Sketch of Service Here**

A large grid for sketching service details, consisting of 20 columns and 12 rows of squares.

Connection made in ..... Street.

Work completed ..... 19..

Remarks: