

Name Frank Bishop

Service No. 86

Address 9 Fuller Road

Location

Kind of Pipe

Size

Size of Main

~~Repair~~ ~~Renewal~~ - New Service

Location

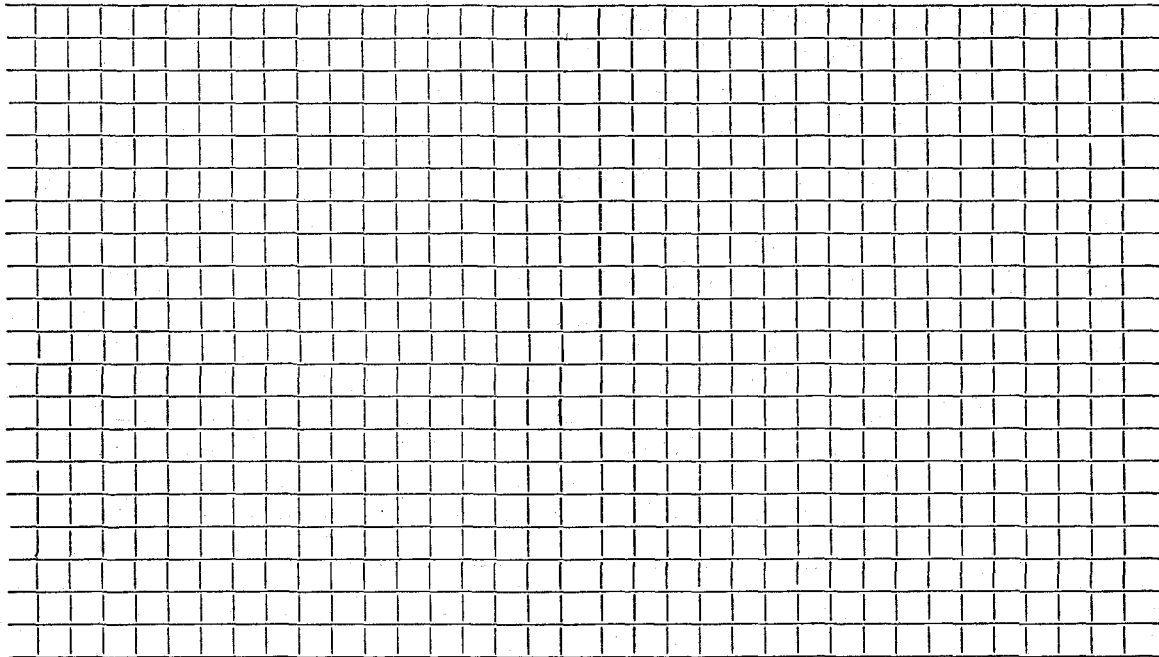
Conn 8-1-62

Date	Material	Amount	Total	Date	Amount
6-14-60	Labor 30.68			5-31-60	150.00
6-15-60	" 79.73	110.41		8-19-60	105.46
	10% O.H.	11.04	121.45		255.46
70'	70' 6" Transite pipe @.78		54.60		
2	11 $\frac{1}{2}$ " Transite Bends @5.10		10.20		
1	22 $\frac{1}{2}$ " Transite Bend		6.21		
6	hrs. Pippin Shovel @4.50		27.00		
3	hrs. Trucking @3.00		9.00		
27'	Patching		27.00		
			255.46		
				Bill sent 8-1-62	105.46

DATE _____

TOWN OF LEXINGTON — BOARD OF PUBLIC WORKS
SEWER DIVISION

Sketch of Service Here

A large rectangular grid of graph paper, consisting of approximately 20 columns and 25 rows of small squares, intended for sketching service details.

Connection made in Street. Work completed

Remarks:
.....
.....