


DATE 7/25/18

TOWN OF LEXINGTON — BOARD OF PUBLIC WORKS
SEWER DIVISION

Sketch of Service Here

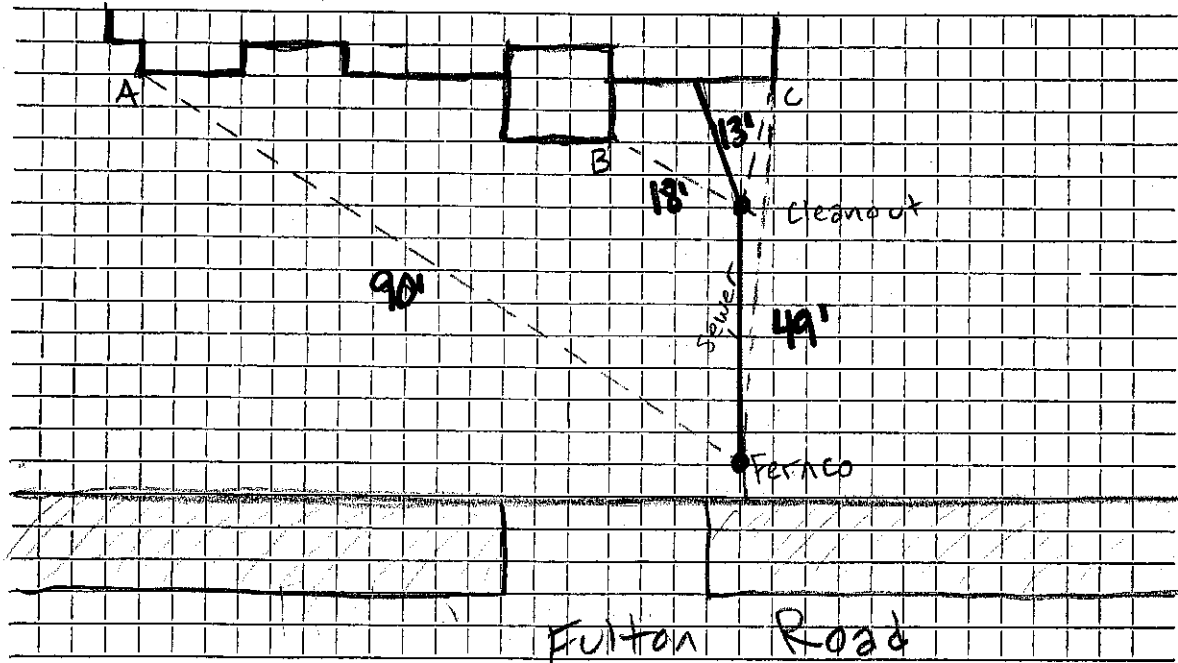

$A F_e C = 90'$
 $C F_e C = 49'$
 $B C_o = 18'$
 $C C_o = 13'$

Connection made in Fulton Street. Work completed

Remarks:
.....
.....