

Name John Fulton

Service No. 6

Address 12 Fulton Road

Location

Kind of Pipe

Size

Size of Main

~~Repair/Replacement~~ New Service

Eagle #4060

Location


JUL 20 1982

Date	Material	Amount	Total	Date	Amount
Nov 170	28' 6" Transite pipe @	7.50	210.00	5-17-82	Deposit
5/18/82	114' 6" PVC				210.00
	17' 4" Iron pipe			11-	-70
	3 22° Elbows			28'	6" Transite
	1 Wye Cleanout				
	1 Cap on C.O.				

TOWN OF LEXINGTON — BOARD OF PUBLIC WORKS

SEWER DIVISION

Sketch of Service Here **12**

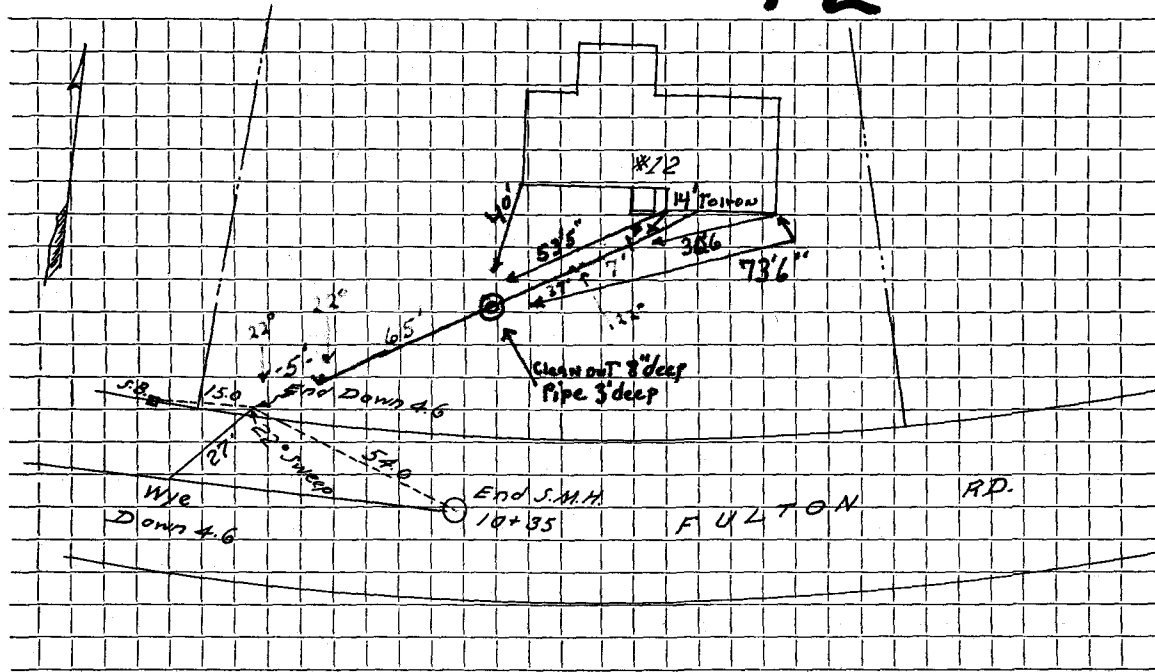

Connection made in Street. Work completed

Remarks: Clean out Cap. 8" deep. Iron Pipe 2'6" deep.

.....
.....