

Name Norman A. Ross

Service No. 123

Address 15 Fulton Road

Location

Kind of Pipe

Size

Size of Main

Repair—Renewal—New Service Valeri #1772

Location


DEC 31 1970

Date	Material	Amount	Total	Date	Amount
Nov 170	25' 6" Transite pipe	@7.50	187.50	11-4-70	Deposit
11/6/70	65' 6" Transite pipe				
	7' 4" Cast Iron Pipe			11- -70	
				25' 6" Transite	
				3/5/98	BLOCKAGE
					100' OUT FROM HOUSE (OUT- OUTSIDE)
					HAD Block 2 Times AT MAIN
					(RESPOND + GET MESSAGE)
					MAY BE NO PITCH

TOWN OF LEXINGTON — BOARD OF PUBLIC WORKS

SEWER DIVISION

15 Sketch of Service Here

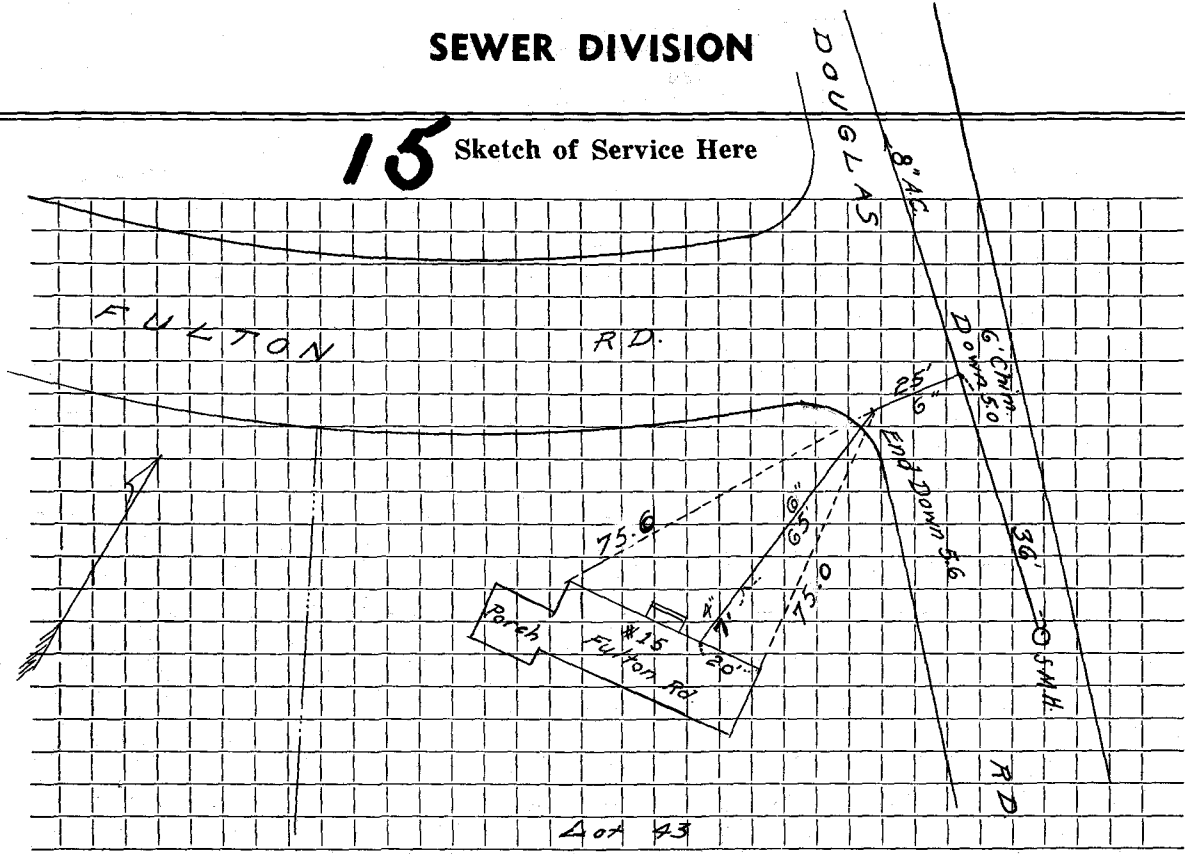

Connection made in Street. Work completed

Remarks: CLEAN OUT - OUTSIDE HOUSE

.....
.....