

Name

Warren J. Thorburn

Service No. ~~73~~

43

Address

2 Fulton Road

Location

Kind of Pipe

Size

Size of Main

Repair—Renewal—New Service Valeri Const. #2282

Location Comm Jun 18, 1973

Date

Material

Amount

Total

Date

Amount

~~Nov '70~~ 25.6' 6" Transite pipe @7.50 192.00 5/14/73 Deposit 192.00

5/15/73 73' 6" Transite pipe

10' 4" Cast Iron


11- - 70

25.6' 6" Transite

TOWN OF LEXINGTON — BOARD OF PUBLIC WORKS

SEWER DIVISION

Sketch of Service Here **2**

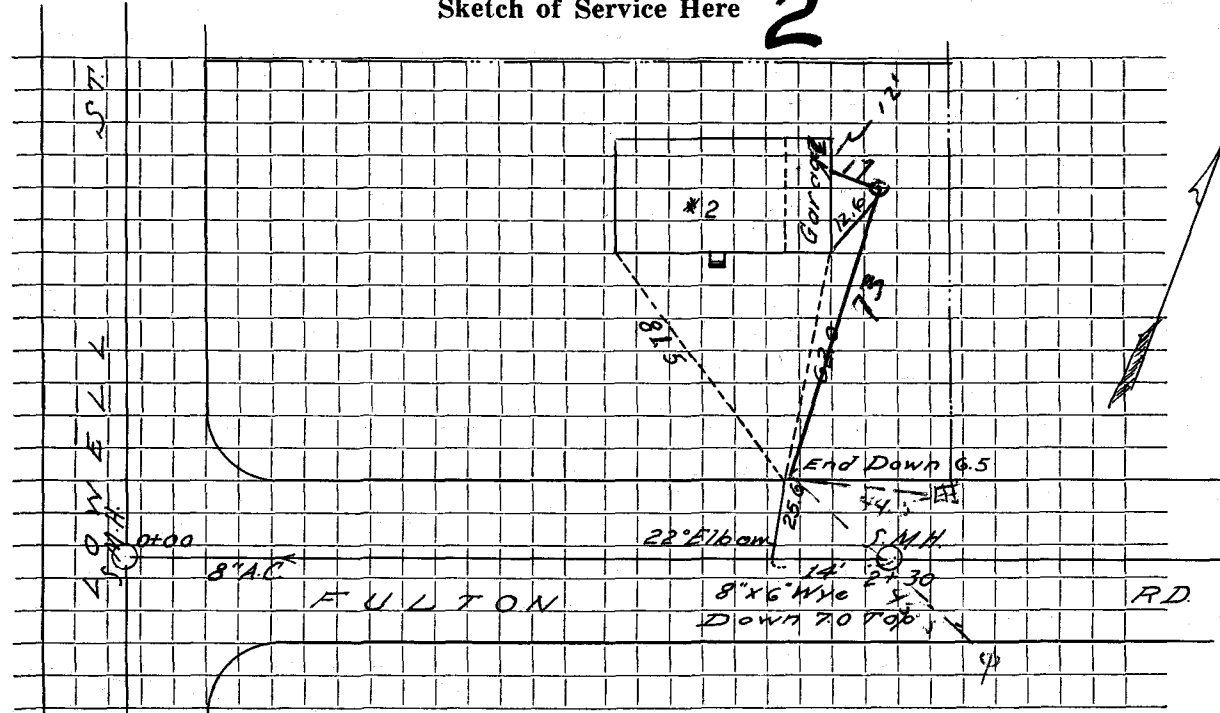

Connection made in Street. Work completed

Remarks:

.....
.....