

Name Naim Hemmat

Service No. 117

Address 5 Fulton Road

Location Lt 47

Kind of Pipe

Size

Size of Main

Repair—Renewal—New Service Valeri #1978

Location JUN 5 1972


Date	Material	Amount	Total	Date	Amount
<del>Nov '70</del>	<del>16' 6" Transite pipe @7.50</del>		120.00	<del>11-18-71</del>	<i>Deposit</i>
12-6-71	45' 6" Transite pipe			11- -70	
	10' 4" Cast Iron pipe			16' 6" Transite	

TOWN OF LEXINGTON — BOARD OF PUBLIC WORKS

SEWER DIVISION

Sketch of Service Here

5

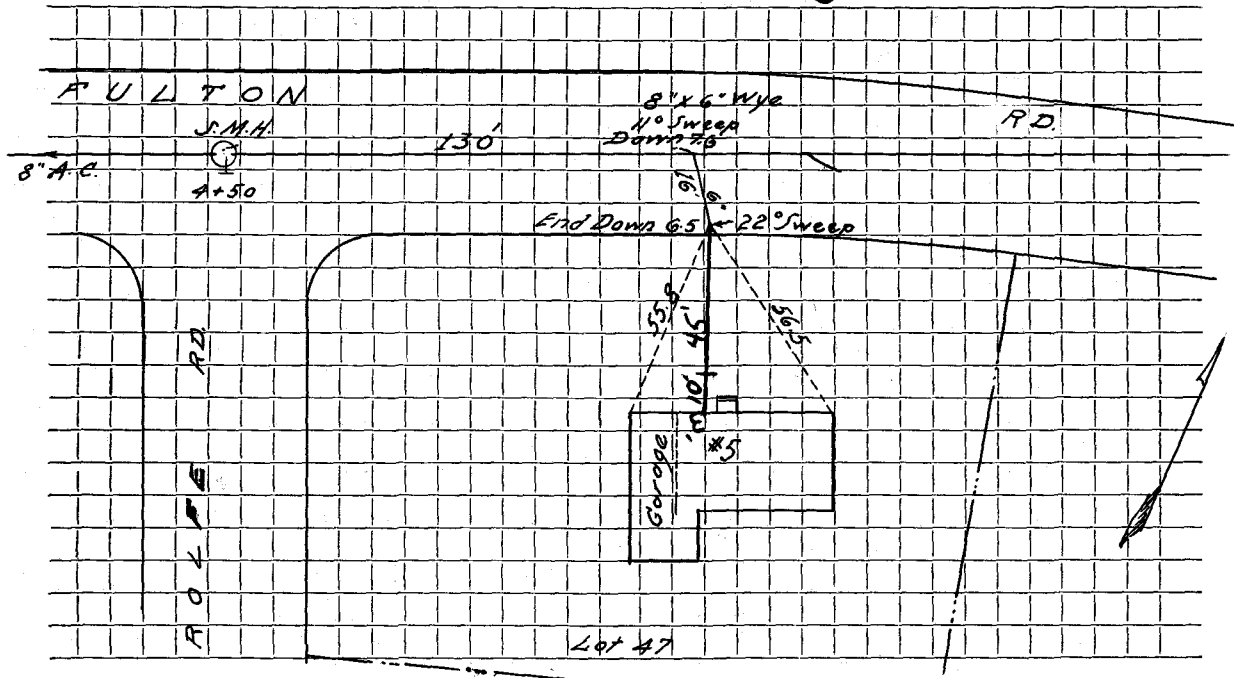

Connection made in ..... Street. Work completed .....

Remarks: .....

.....

.....