


DATE _____

TOWN OF LEXINGTON — BOARD OF PUBLIC WORKS

SEWER DIVISION

Sketch of Service Here

LOT 3

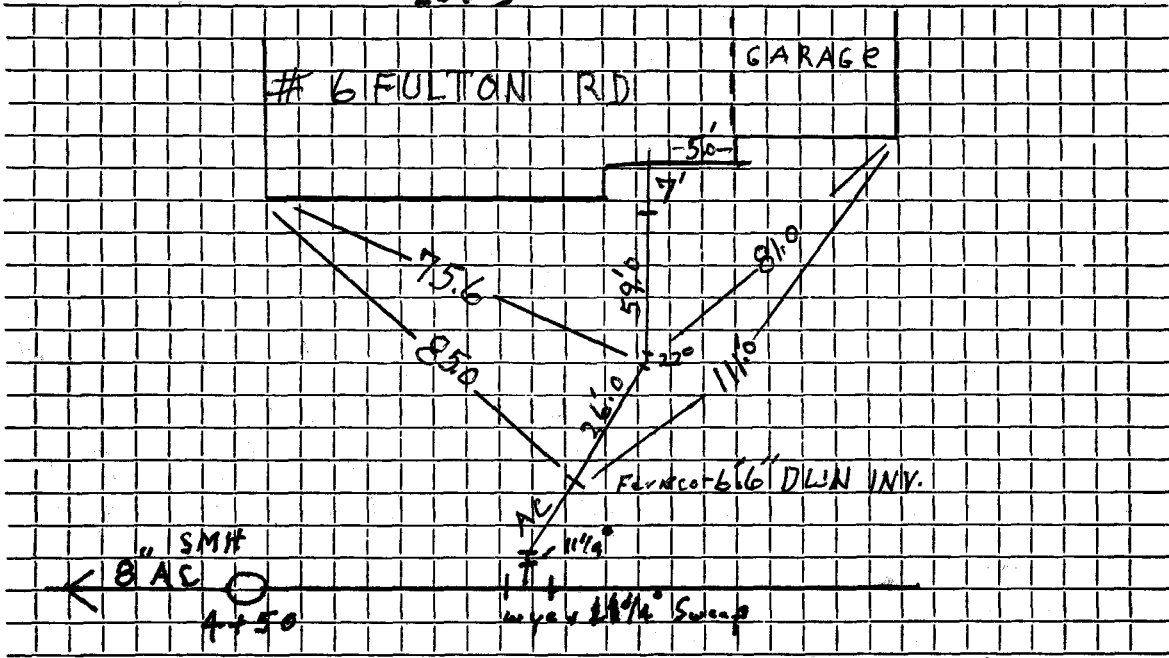

Connection made in Street.

Work completed 7/27/05 J. McLaughlin

Remarks:

.....

.....