


TOWN OF LEXINGTON — BOARD OF PUBLIC WORKS

SEWER DIVISION

DATE 4/29/21

Sketch of Service Here

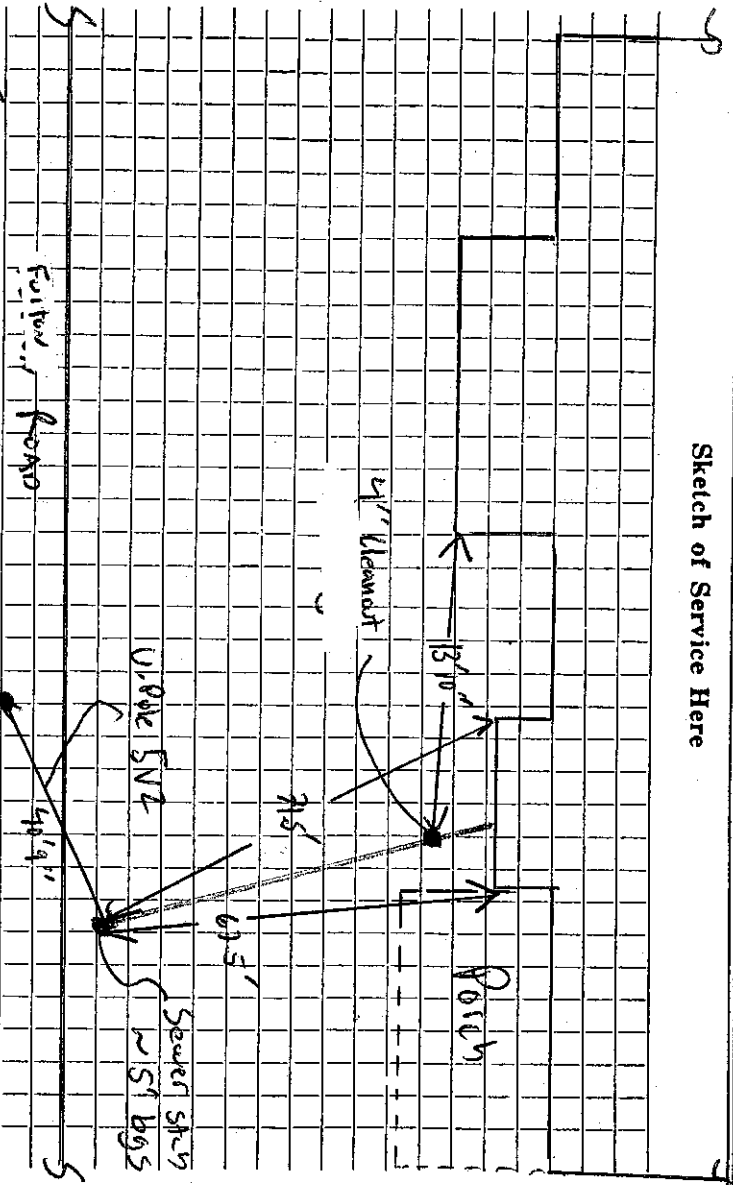


Connection made in Fulton Street Work completed

Remarks:

TOWN OF LEXINGTON — BOARD OF PUBLIC WORKS

SEWER DIVISION

7 Sketch of Service Here

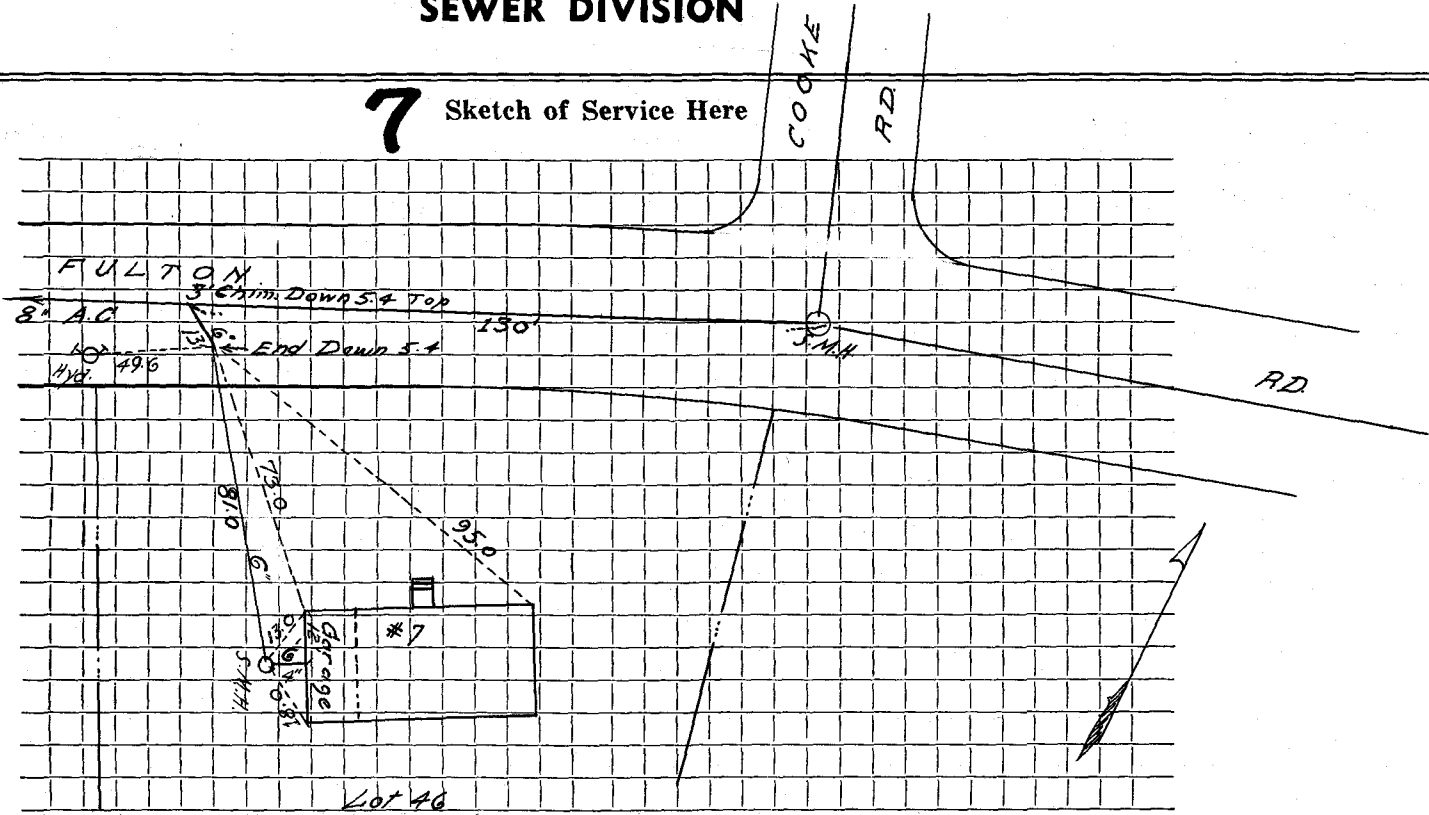

Connection made in Street. Work completed

Remarks:
.....
.....