


DATE 2/22/22

TOWN OF LEXINGTON — BOARD OF PUBLIC WORKS
SEWER DIVISION

Sketch of Service Here

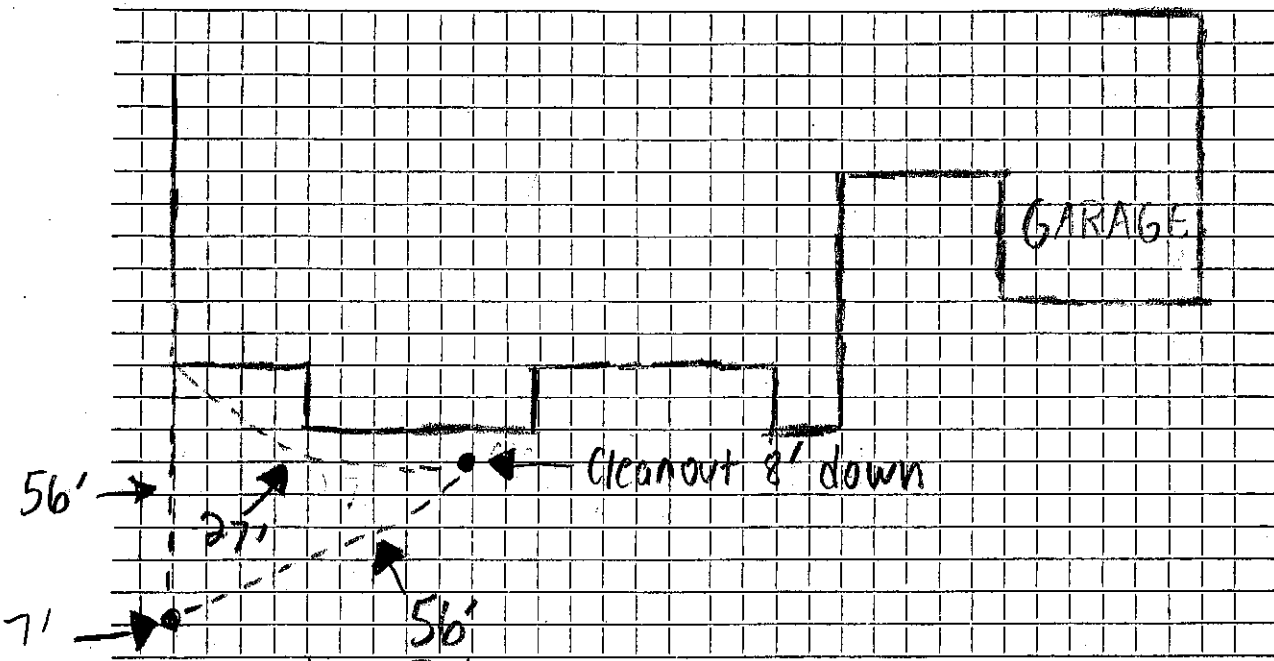

Connection made in 8 Fulton Rd Street. Work completed

Remarks: INSTALLED By TBR EXCAVATING