

Name Eshter M. Samson

Service No. 138

Address 11 Garfield Street

Location

Kind of Pipe

Size

Size of Main

~~Repair - Extension~~ New ServiceLocation *Comm 11-16-59*

Date	Material	Amount	Total	Date	Amount
0-27-59	Labor	65 46		8-19-59	150 00
0-28-59	"	43 31		<del>11-16-59</del>	<del>64 89</del>
		108 77		11-16-59	26 23
	10% O. H.	10 88	119 65	4-20-60	34 89
1/5	6" Transite pipe @.70		31 50		211 62
1	6" Clay Elbow		1 88		
1	6" Clay Y		1 16		
1	20" Cesspool Cover & Frame		10 50		
1/0	Barrel Block		11 48		
200	Bricks @4.20 /100		8 40		
2	Bags Cement @1.50		3 00		
3	Hrs. Trucking @.75		2 25		
2	<del>hrs.</del> Town Shovel @6.50		13 00		
1	Hr. Trojan Loader @3.00		3 00		
1	Hr. Rogers Trailer @3.00		3 00	<i>Bill sent 11-16-59</i>	34 89
1	Hr. Trucking @3.00		3 00		
			211 82		

# TOWN OF LEXINGTON—DEPT. OF PUBLIC WORKS

## SEWER DIVISION

DATE.....

NO. ....


The undersigned applies for the construction of a particular sewer connecting No..... Street and hereby agrees to comply with the Rules and Regulations governing the construction and use of Particular Sewers, as now or at any future time established by the Board of Selectmen.

Am't of estimate \$.....

Am't Paid \$.....

..... Owner

**Sketch of Service Here**

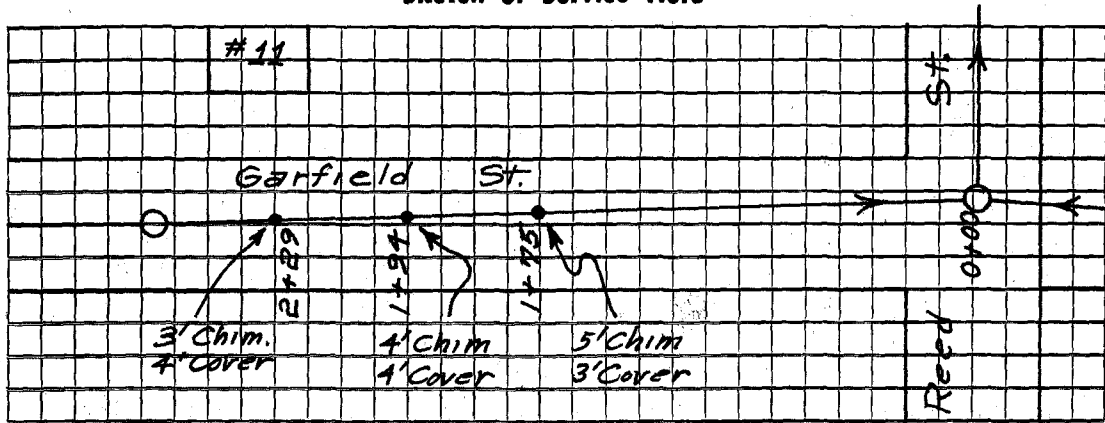

Connection made in ..... Street.

Work completed ..... 19..

Remarks: