

Name

Service No.

Address

11A Garfield Street

Location

Kind of Pipe

Size

Size of Main

Repair—Renewal—New Service

Richard Gately - Permit #619


Location

Date		Material	Amount		Total		Date		Amount	
6/13/67	30'	6" Transite								
	10'	Cast Iron (1/4")								

DATE _____

TOWN OF LEXINGTON — BOARD OF PUBLIC WORKS
SEWER DIVISION

Sketch of Service Here

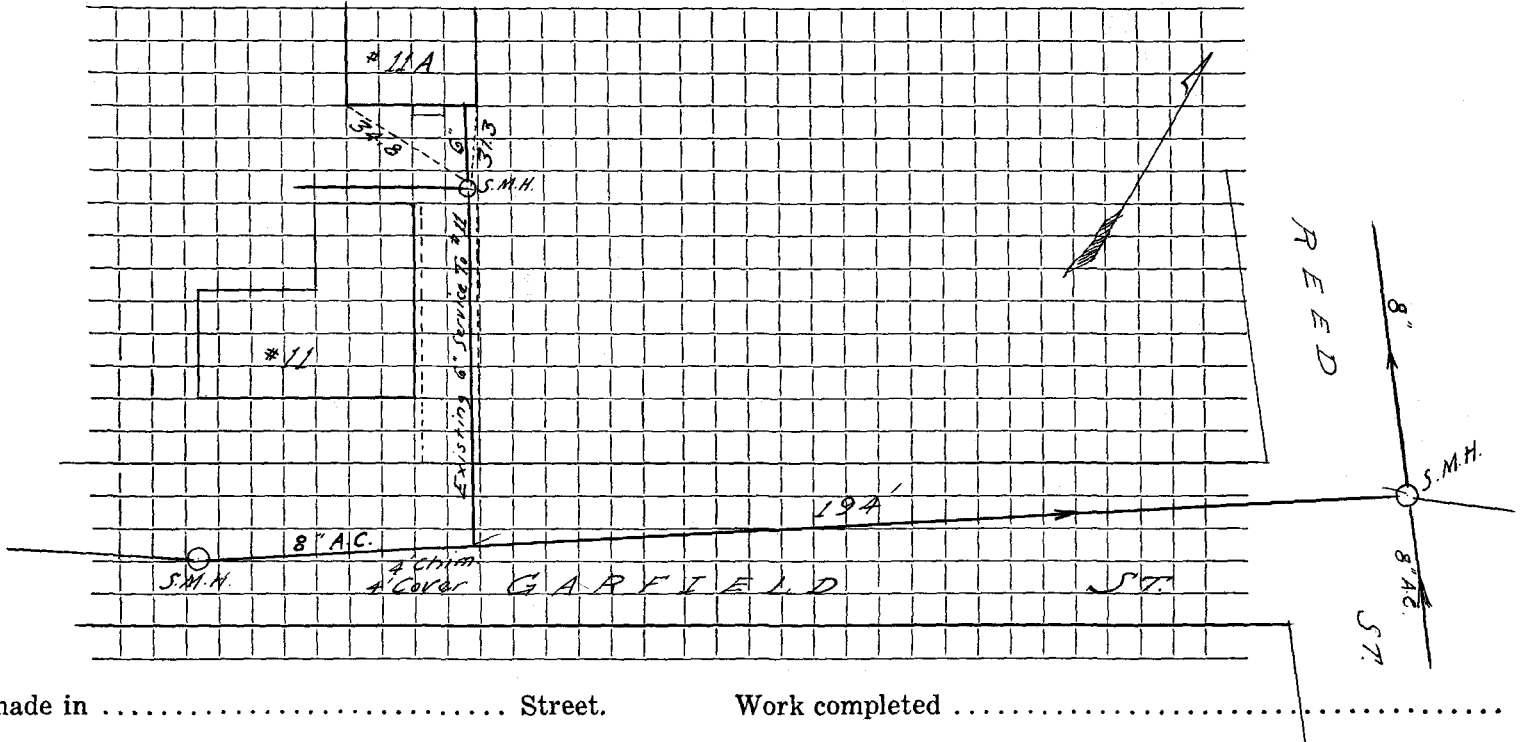

Connection made in Street. Work completed

Remarks:
.....
.....