

Name

Service No.

Address

19 Garfield

Location

Kind of Pipe

Size

Size of Main

Repair Renewal New Service

Location

Date

Material

Amount

Total

Date

Amount

11-12-09

10' - 4" PVC


53' - 6" PVC

4x6 PVC to PVC FERNCO

2 - 6" 45° Bends

DATE \_\_\_\_\_

**TOWN OF LEXINGTON — BOARD OF PUBLIC WORKS**  
**SEWER DIVISION**

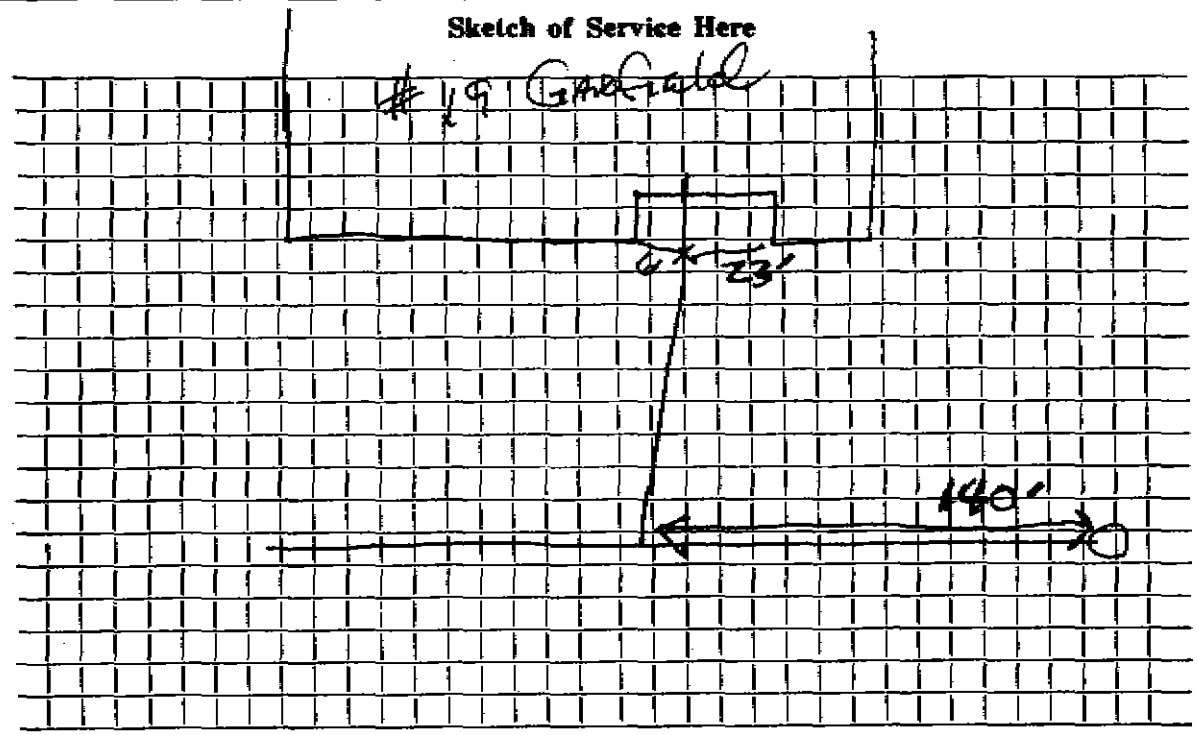

Connection made in ..... Street. Work completed .....

Remarks: *Service installed from house to main - service goes into the top of main.*