

Name James O'Shaughnessy

Service No. 166

Address 20 - 24 Garfield Street

Location

Kind of Pipe

Size

Size of Main

~~XXXXXX~~ New Service


Location *CORNER 11-30-59*

Date	Material	Amount	Total	Date	Amount
9-22-59	Labor	81.98		9-11-59	350.00
9-23-59	"	22.50	104.48	11-30-59	113.73
	10% O.H.	10.45	114.93		236.27
	100' 6" Transite pipe @.70		70.00		
	1 Cesspool Cover & Frame		10.50		
	1 6" 45° Transite Elbow		2.79		
	2 bags Cement @1.50		3.00		
	150 Sewer Brick @4.20 per 100		6.30		
	1 ton Brick Sand @1.00		1.00		
	3 hrs. Town Shovel @6.50		19.50		
	3 hrs. Trucking @.75		2.25		
	1 hr. Rogers Trailer @3.00		3.00		
	1 hr. Trucking @3.00		3.00		
			236.27		

DATE \_\_\_\_\_

TOWN OF LEXINGTON — BOARD OF PUBLIC WORKS  
SEWER DIVISION

Sketch of Service Here

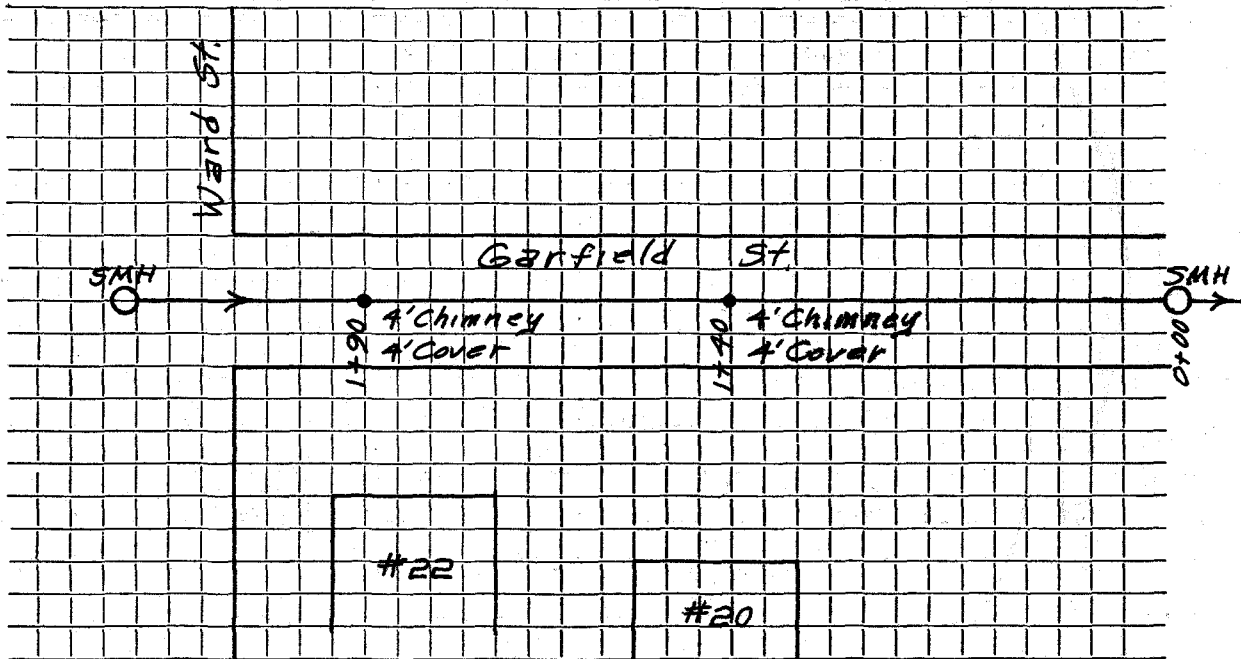

Connection made in ..... Street. Work completed .....

Remarks: .....  
.....  
.....