

Name

Service No. 3014

Address 20 Garfield ST

Location

Lot 518

Kind of Pipe PVC

Size 6"

Size of Main 8" A.C.

Repair—Renewal—New Service

J. McLaughlin

Location

Date Material Amount Total Date Amount

9/19/08 10' 4" PVC

53' 6" PVC

1 4x6 Ferra


1 8"x6" Sewer Saddle

Sewer Main A.C.

DATE \_\_\_\_\_

TOWN OF LEXINGTON — BOARD OF PUBLIC WORKS  
SEWER DIVISION

Sketch of Service Here

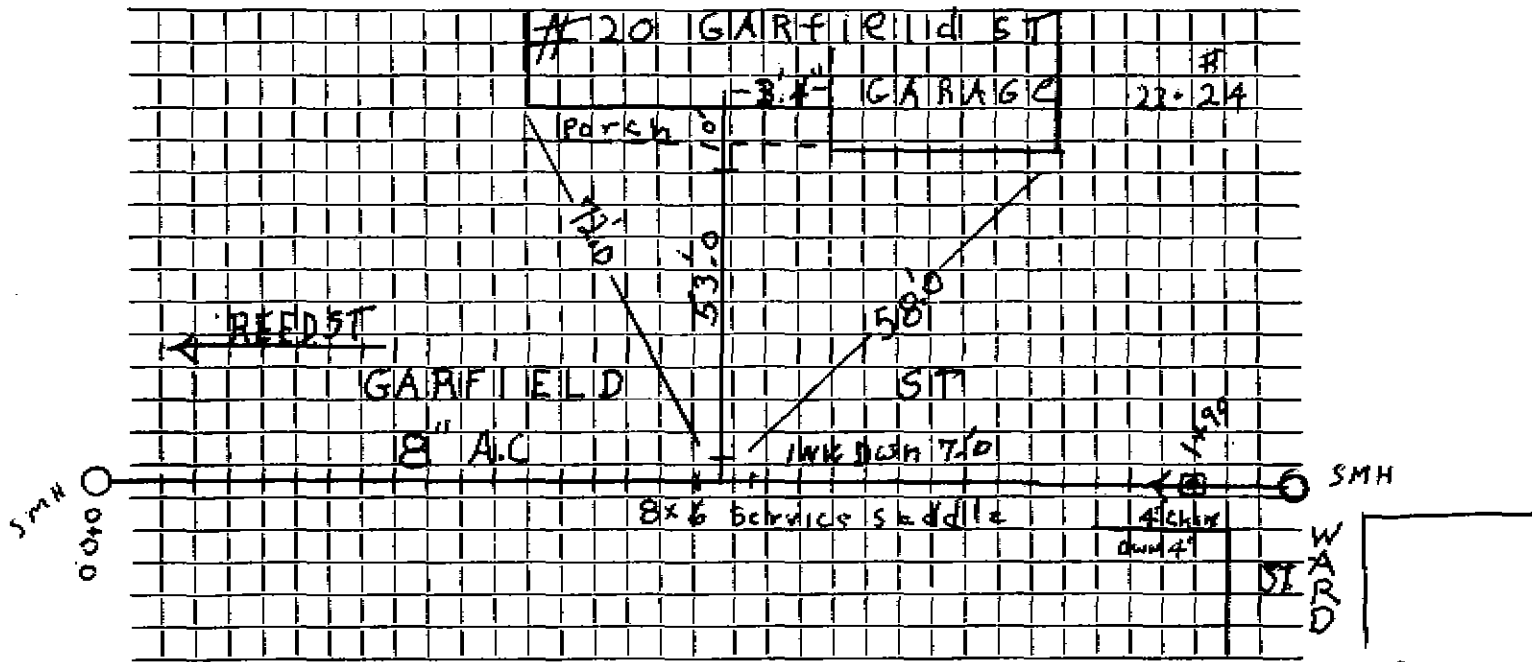

Connection made in \_\_\_\_\_ Street. Work completed 9/10/08 J. McL

Remarks: \_\_\_\_\_  
 \_\_\_\_\_  
 \_\_\_\_\_