




DATE \_\_\_\_\_

TOWN OF LEXINGTON — BOARD OF PUBLIC WORKS

SEWER DIVISION

Sketch of Service Here

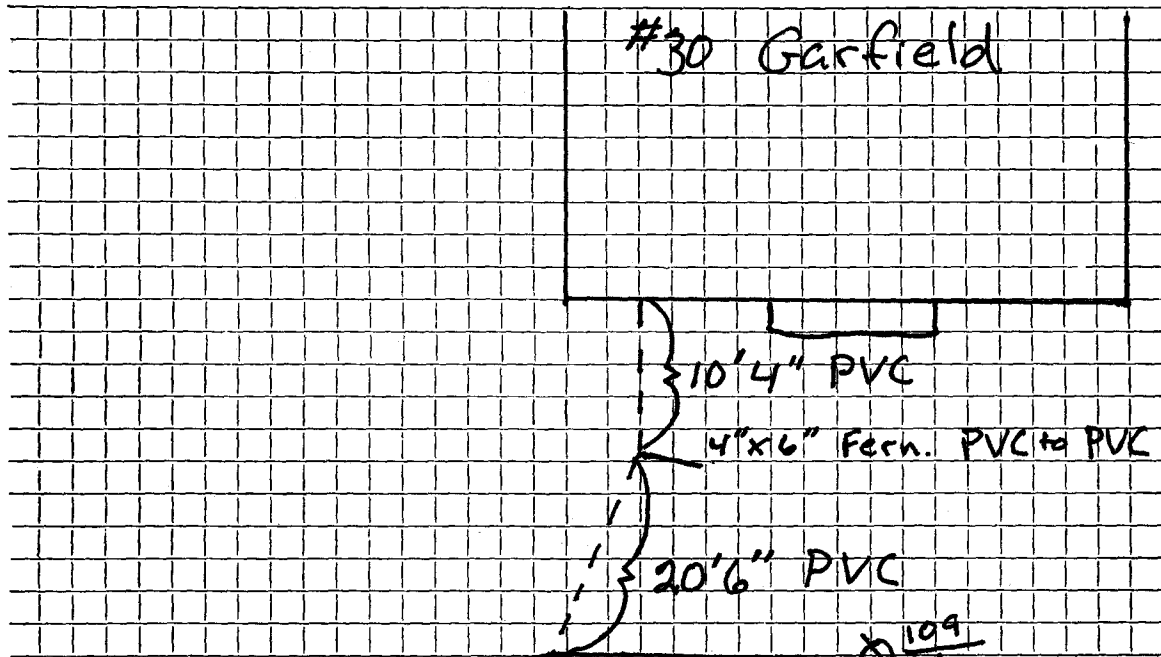

Connection made in ..... 19' ..... Street. } 20' Work completed ..... SMH

Remarks: ..... SMH ..... SMH

..... 99' .....