


DATE 7-26-77

TOWN OF LEXINGTON — BOARD OF PUBLIC WORKS
SEWER DIVISION

Sketch of Service Here **31**

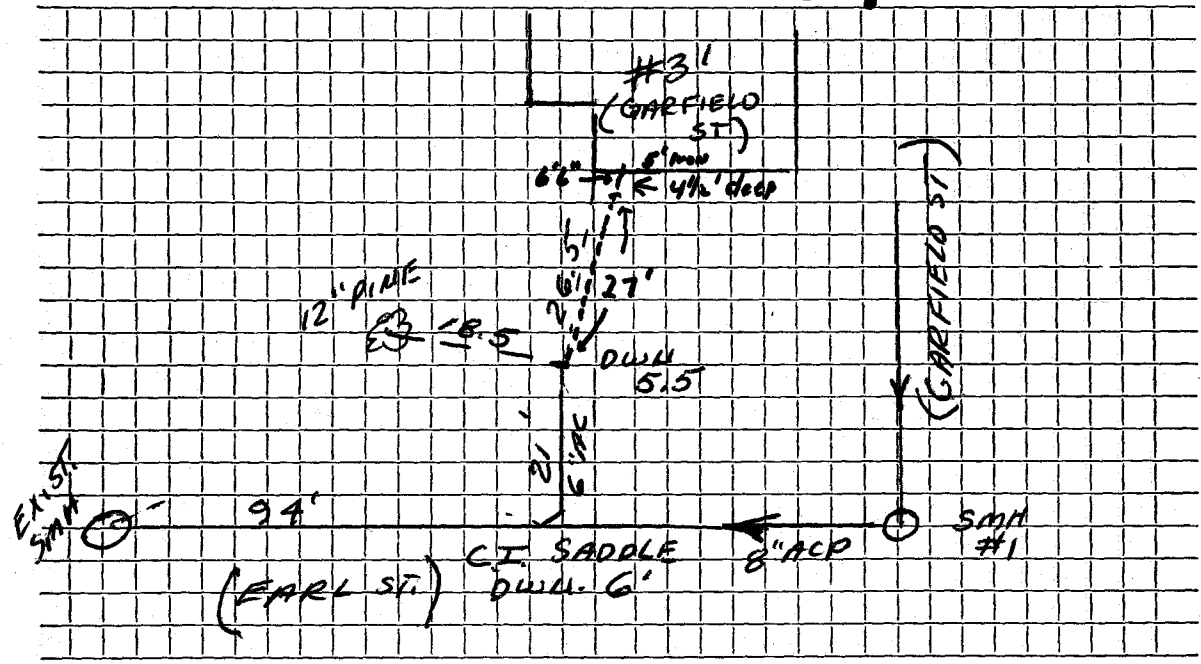

Connection made in Earl Street. Work completed

Remarks:
.....
.....