


DATE 7-22-77

TOWN OF LEXINGTON — BOARD OF PUBLIC WORKS
SEWER DIVISION

Sketch of Service Here

36

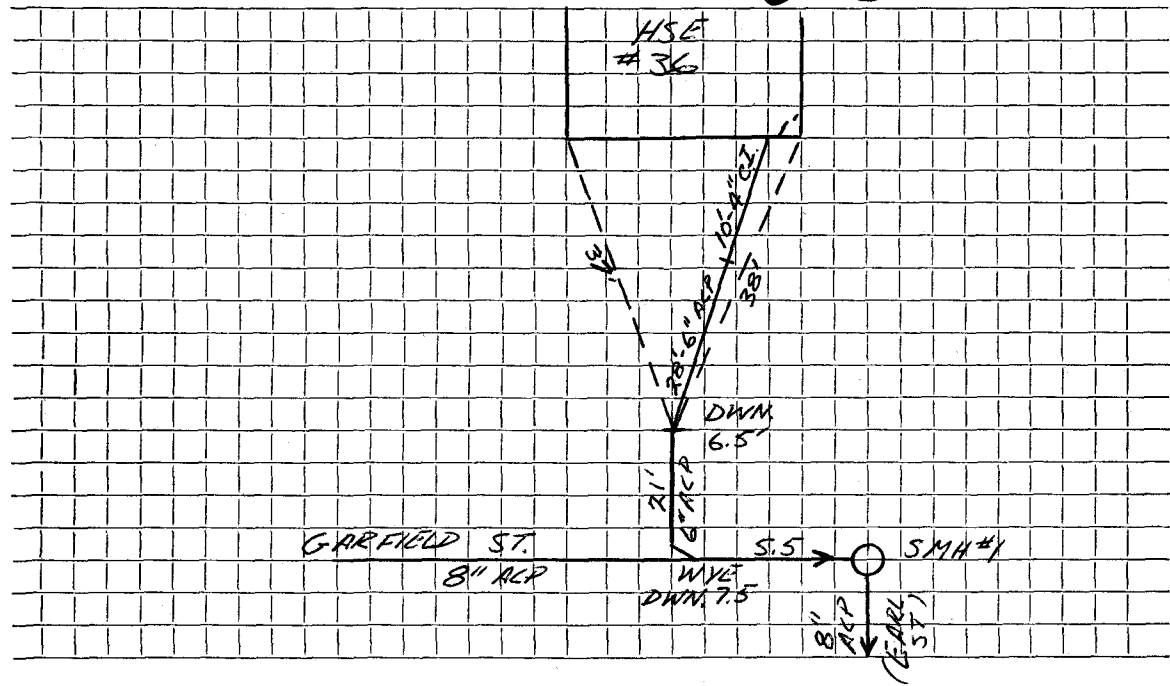

Connection made in GARFIELD Street. Work completed

Remarks:
.....
.....