




DATE Aug 2, 1977

TOWN OF LEXINGTON — BOARD OF PUBLIC WORKS  
SEWER DIVISION

Sketch of Service Here **40**

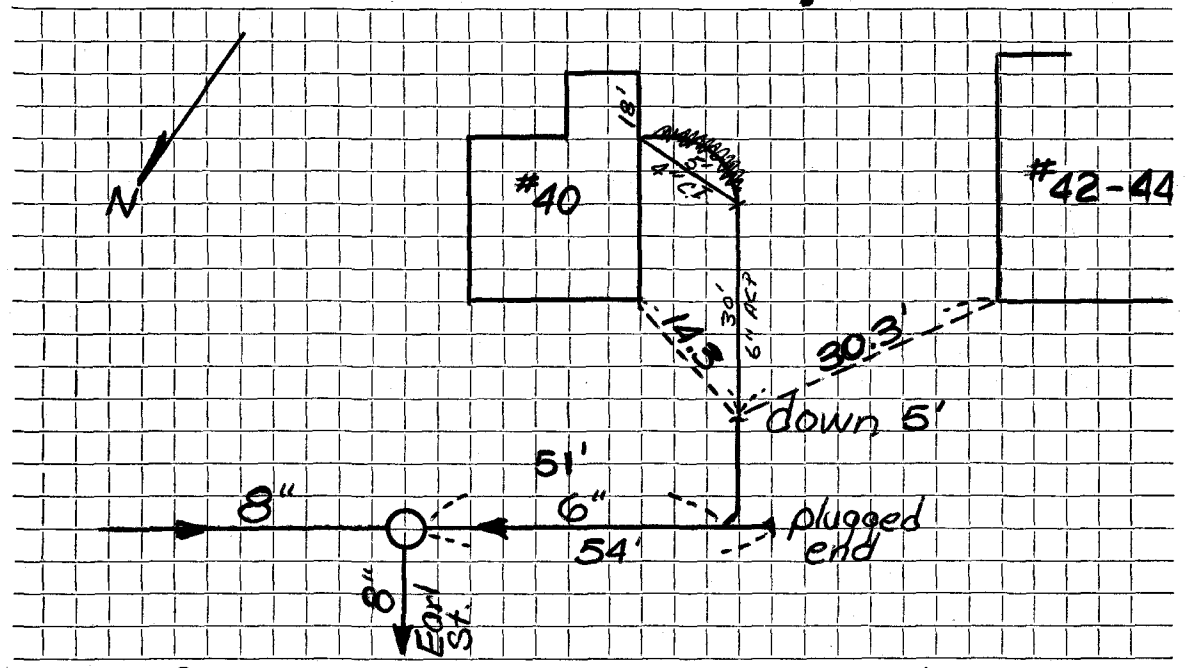

Connection made in Gorfield Street. Work completed July 20, 1977

Remarks: .....

.....

.....