

Name .

Service No.

Address

5 Garfield Street

Location

Kind of Pipe

Size

Size of Main

Repair—Renewal—New Service

Location

Date	Material	Amount	Total	Date	Amount
9-21-59	73' 6" Transite				
	1 6"-22 1/4° Bend				
	1 6" Duplex Adapter				
	1 6"-90° Elbow				


DATE _____

TOWN OF LEXINGTON — BOARD OF PUBLIC WORKS

SEWER DIVISION

Sketch of Service Here

5

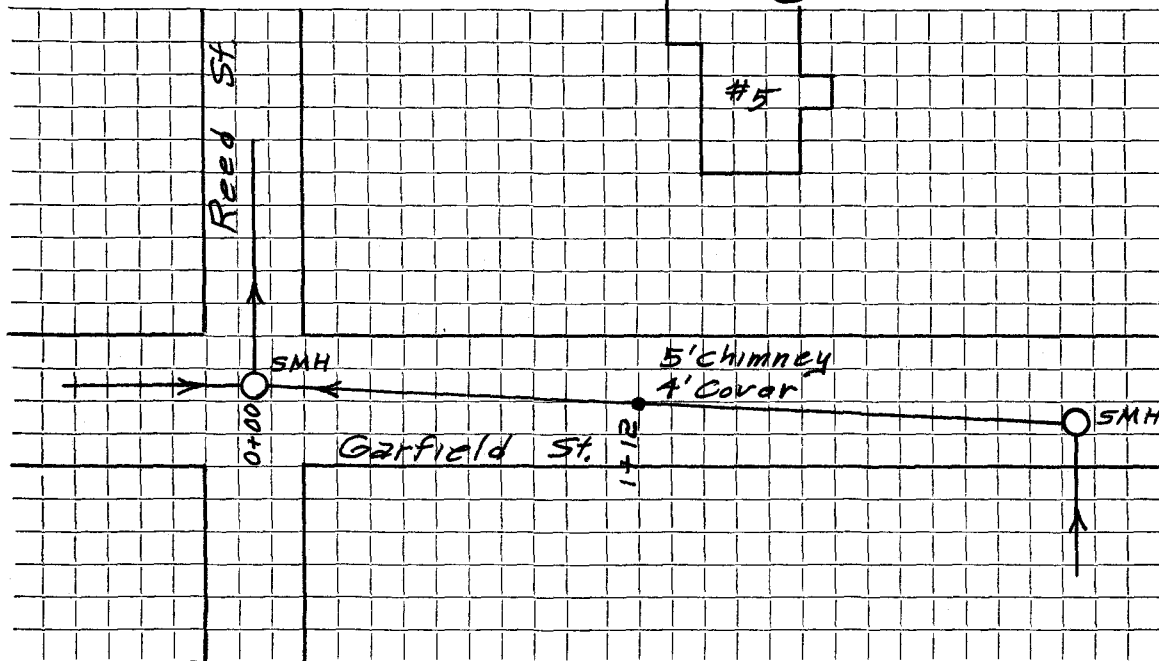

Connection made in Street. Work completed

Remarks:
.....
.....