

Name Hall & Co., Realtors 1656 Mass Ave., Lexington

Service No. 4

Address 6 Garfield Street

Location

Kind of Pipe

Size

Size of Main

Repair—Renewal—New Service DeFlice Bros. # 2390


W.O.# 1734 Location Comm 7-28-75

Date	Material	Amount	Total	Date	Amount
				1-31-74	300.00
2-12-74	26' - 6" ACP			7-28-75	123.74
	10' - 4" CI				176.26
2/1/74	Labor	87.72			
	10% O.H.	8.58			
			\$94.30		
	30' 6" Transite Pipe	1.10	33.00		
	1 8 x 8 saddle		11.97		
	1 Close nipple		1.76		
	1 90 elbow		5.63		
	1 6" Plug		11.10		
	1 Hr. Pickup		1.50		
	2 Hrs. Backhoe @6.50		13.00		
	1 Hr. Cooder		4.00		
			\$176.26		

DATE _____

TOWN OF LEXINGTON — BOARD OF PUBLIC WORKS

SEWER DIVISION

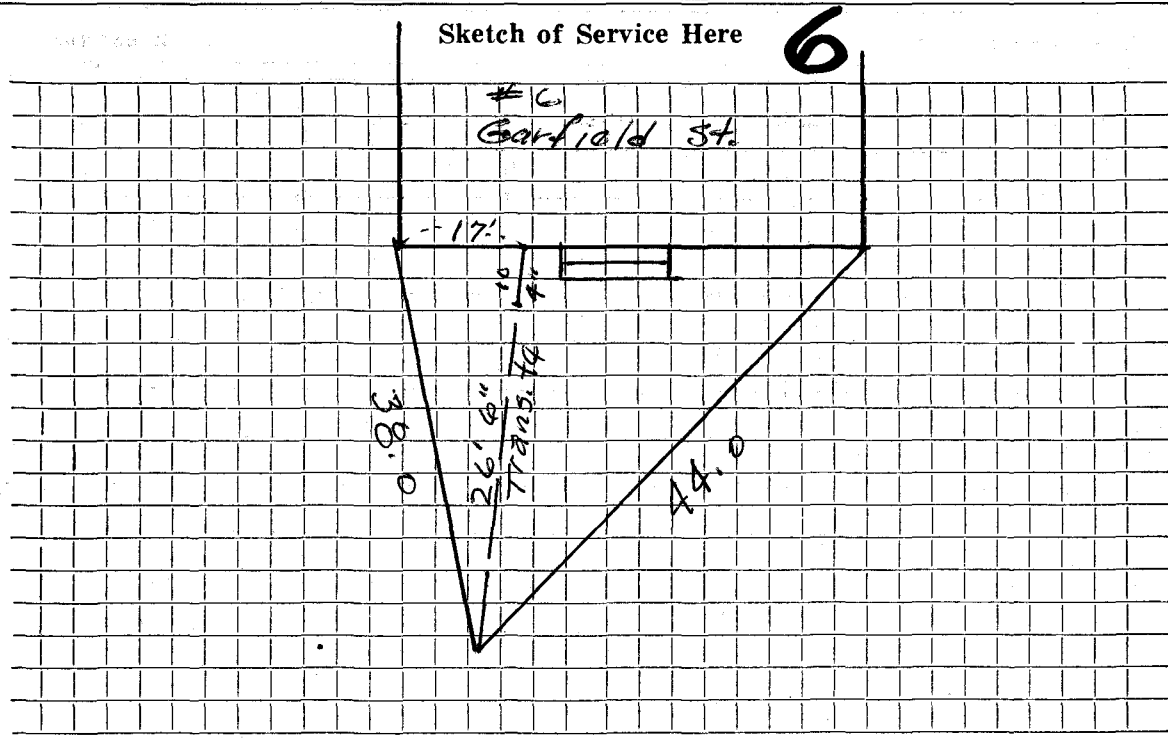

Connection made in Street. Work completed

Remarks:
.....
.....