




DATE 15 August 1996

TOWN OF LEXINGTON — BOARD OF PUBLIC WORKS

SEWER DIVISION

Sketch of Service Here

68

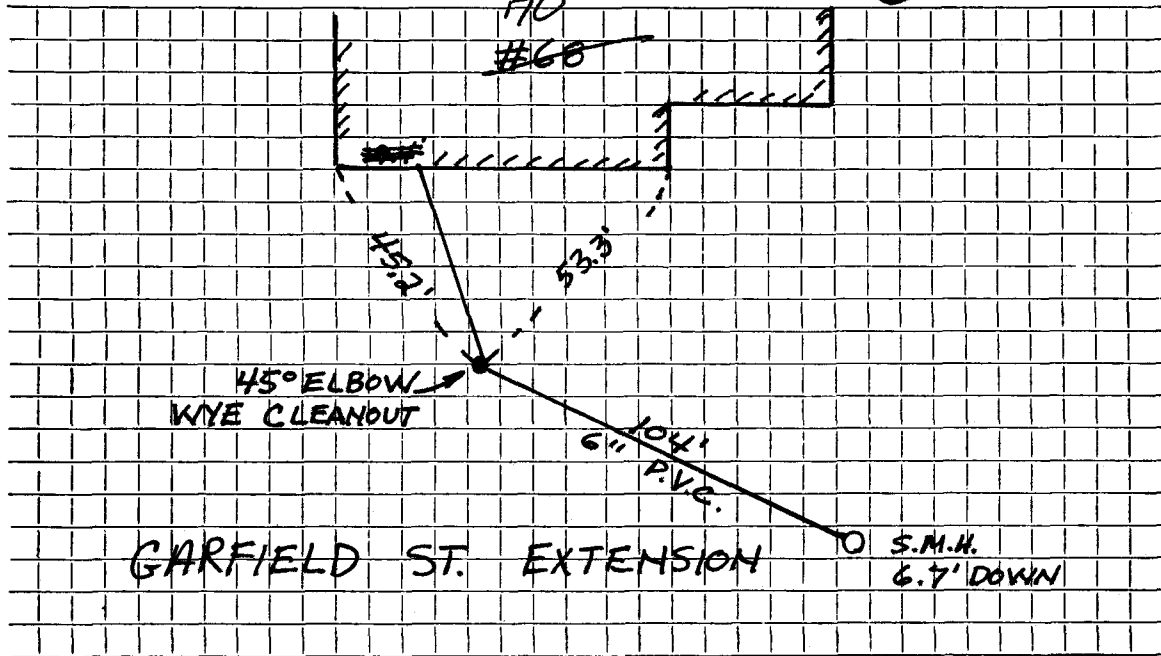

Connection made in GARFIELD ST. EXT. Street.

Work completed F.H.P. Construction Service, Inc.

Remarks: .....

.....

.....