

Name Dianne Estates

Service No. 128

Address 5 Gerard Terrace

Location

Kind of Pipe

Size

Size of Main

~~REPLACEMENT~~ New Service

Location *Corner 8-22-60*


Date	Material	Amount	Total	Date	Amount
7-18-60	Labor	20 01		<i>7-15-60</i>	<i>Deposit</i> 100 00
	10% O.H.	<u>2 00</u>	22 01	<i>8-22-60</i>	<i>Retard</i> <u>125</u>
	88' 6" Sewer pipe @78		68 64		<i>98 75</i>
	1 11 $\frac{1}{4}$ ° Transite Bend		5 10		
	1 Hr Trucking @3.00		<u>3 00</u>		
			98 75		

DATE \_\_\_\_\_

TOWN OF LEXINGTON — BOARD OF PUBLIC WORKS  
SEWER DIVISION

Sketch of Service Here

5

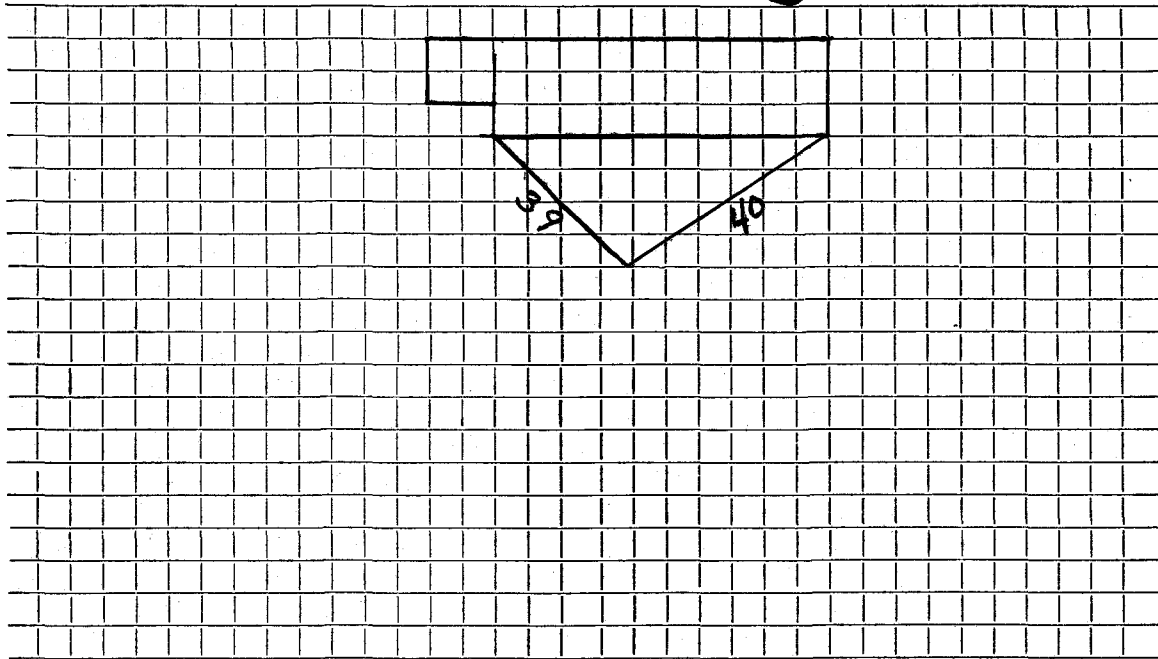

Connection made in ..... Street. Work completed .....

Remarks: .....  
.....  
.....