

Name

Service No.

Address

6 GIDSEN

Location

Kind of Pipe

SDR

Size

6"

Size of Main

Repair ~~Renewal~~ New Service

Location

Date

Material

Amount

Total

Date

Amount

4/17/12

- 6" SDR

- 6" CLEAN OUT

6" SDR RISER

6" PVC CAP

6" TELE WYE


- 8x6" FERRO

PVC → AC

DATE 6/13/14

TOWN OF LEXINGTON — BOARD OF PUBLIC WORKS
SEWER DIVISION

Sketch of Service Here

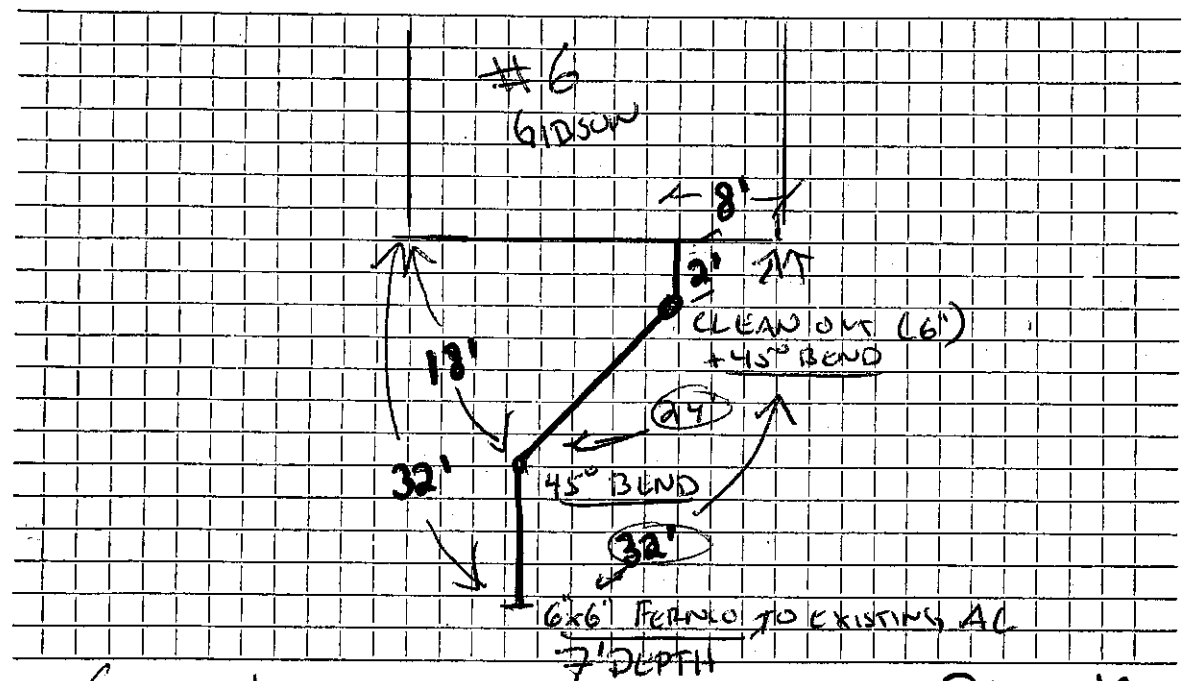

Connection made in GIBSON Street. Work completed PAUL YOUNG

Remarks:

.....

.....