


DATE 10-19-'90

TOWN OF LEXINGTON — BOARD OF PUBLIC WORKS
SEWER DIVISION

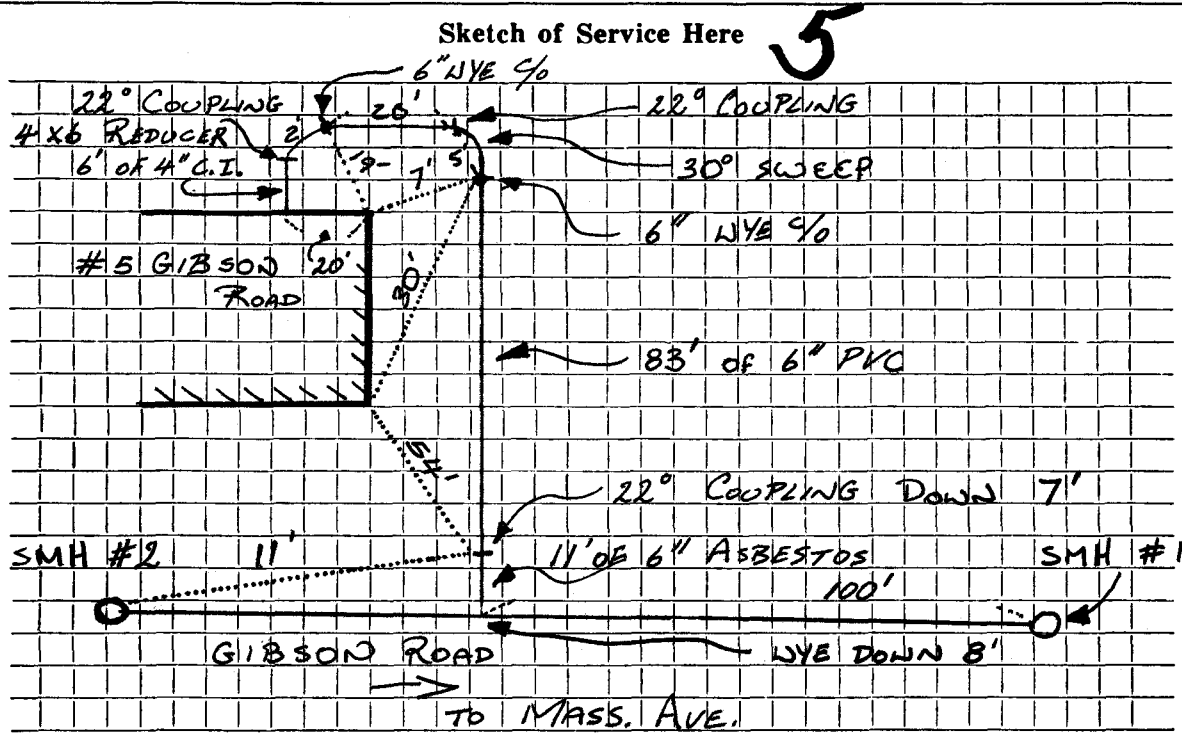

Connection made in ... GIBSON ROAD ... ~~SEWER~~ Work completed

Remarks: INSPECTED 10-13-'90 BY P. BARROWS. CONSTRUCTION BY B. VALERI