

Name

Service No.

Address

97 GLUASW

Location

Kind of Pipe

SDR35

Size

6"

Size of Main

Repair—~~Renewal~~—New Service

Location

Date

Material

Amount

Total

Date

Amount

6/0/17


- 6" SDR

- 6" x 6" FURNACE  
PVC → AC

DATE 6/10/17

TOWN OF LEXINGTON — BOARD OF PUBLIC WORKS  
SEWER DIVISION

Sketch of Service Here

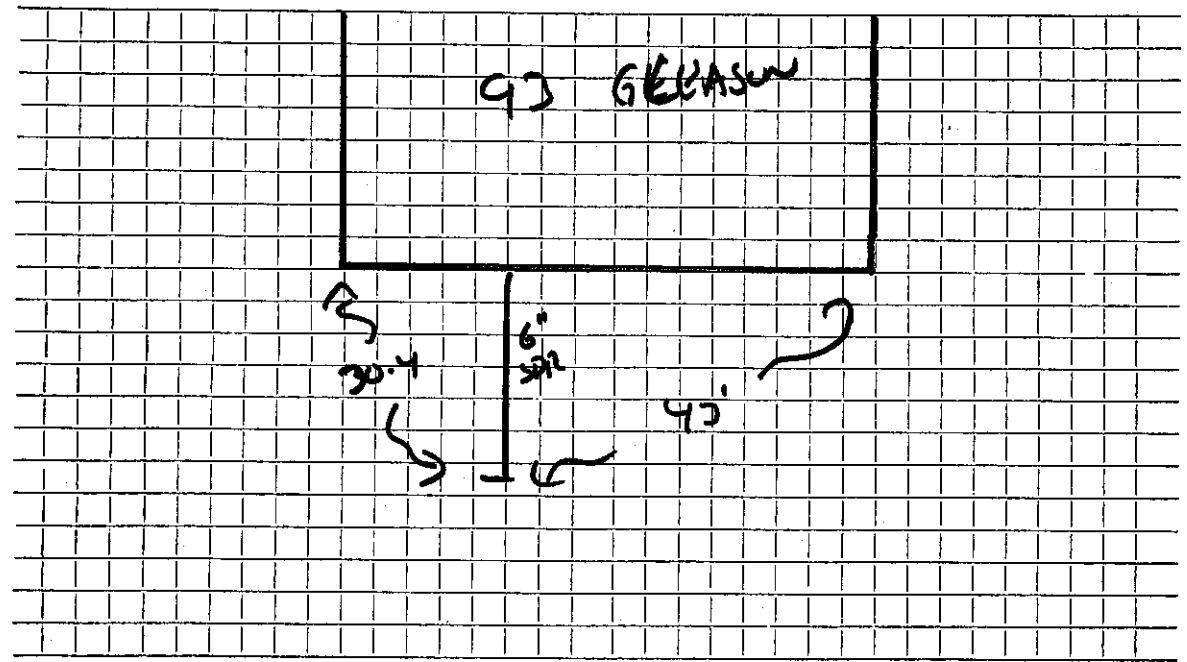

Connection made in GLEASON Street. Work completed TAYLOR CRT.

Remarks: .....

.....

.....