

Name Frank Custance

Service No. 191

Address 100 Gleason Road

1953

Location

Kind of Pipe

Size

Size of Main

~~Repair or Renewal~~ - New Service

Com. 6-1-54

Location

Date	Material	Amount	Total	Date	Amount
5/4/54	Labor	21 88		10-27-53	100 00
5/5/54	Labor	20 65		6-1-54	6 30
		42 53			93 70
	10% Overhead	4 25	46 78		
	34' 6" Sewer Pipe @.3087		10 50		
	1 6" Elbow		1 88		
	Joint Compound		2 04		
	2 hrs. Ltfld. Shovel @ 7.50		15 00		
	2 hrs. trucking		1 50		
	Patching 16x3		16 00		
			93 70		
	Labor				

TOWN OF LEXINGTON—DEPT. OF PUBLIC WORKS
SEWER DIVISION

DATE.....

NO.....

The undersigned applies for the construction of a particular sewer connecting No.....
Street and hereby agrees to comply with the Rules and Regulations governing the construction and use of Particular
Sewers, as now or at any future time established by the Board of Selectmen.


Am't of estimate \$.....

Am't Paid \$.....

..... Owner

Sketch of Service Here

1000

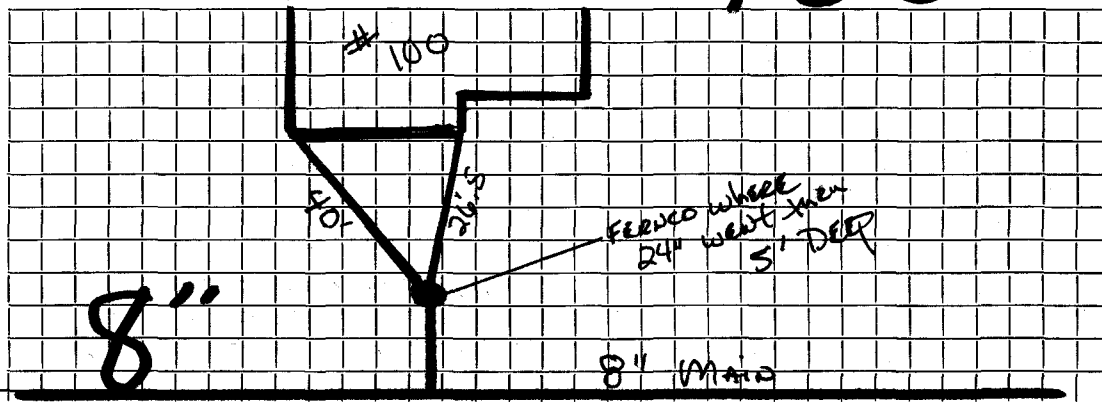

Connection made in..... Street.

Work completed.....19..

Remarks: