

Name **W. C. Pritchett**

Service No.

Address **102 Gleason Road**

Lexington, Mass.

Location **102 Gleason Road**

Kind of Pipe

Size

Size of Main

~~REPAIR~~ **RENEWAL - New Service**

Com. **6-27-49**

Location

Date	Material	Amount	Total	Date	Amount
May 3, '49	Labor	65 10	65 10	April 21 '49	10000
	10% Overhead		6 51	June 30 '49	2169
	50' - 6" Sewer Pipe @.27		13 50		12831
	Joint Compound		3 00		
	1 - Bog of cement		1 20		
	Littlefield Shovel 3½ hrs. @7.00		24 50		
	Trucking 2 hrs. @.75		1 50		
	Patching 13 x 3		13 00		
			128 31		
	Labor				

TOWN OF LEXINGTON—DEPT. OF PUBLIC WORKS
SEWER DIVISION

DATE

NO.

The undersigned applies for the construction of a particular sewer connecting No.
Street and hereby agrees to comply with the Rules and Regulations governing the construction and use of Particular
Sewers, as now or at any future time established by the Board of Selectmen.


Am't of estimate \$.....

Am't Paid \$.....

..... Owner

Sketch of Service Here

102

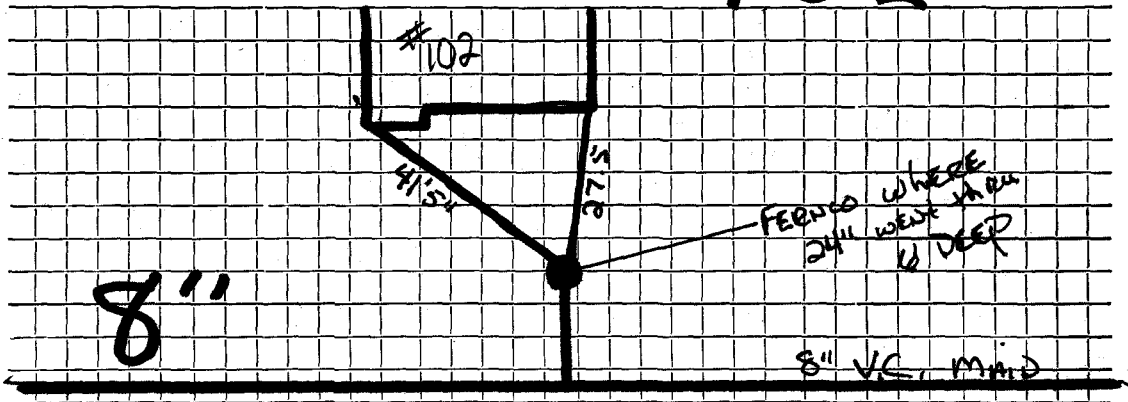

Connection made in Street.

Work completed 19..

Remarks: