

Name Charles McAllister

Service No. 33

Address 105 Gleason Road

Location

Kind of Pipe

Size

Size of Main

~~Repair~~ Renewal ~~New Service~~ W.O. #6720

Location NOV 18 1968


| Date | Material | Amount | Total | Date | Deposit | Amount |
|------------|---|--------|--------|---------------------|----------------------|--------------------------|
| 5/23/68 | Labor | 55 35 | | 5-16-68 11-18-68 | Retained | 100.00 21.27 78.73 |
| | 10% O.H. | 5 51 | 60 89 | 5/22/68 | OUTSIDE | |
| 60 | 6" Transite @ .88 | | 52 80 | 15' | 6" Transite @ .88 | 13 20 |
| 2 | 1 1/4" Elbow @ 2.35 | | 4 70 | 1/2 | Bag Cement | 39 |
| 1 | 22 1/2 Elbow @ | | 2 35 | 1 | Saddle | 5 50 |
| 2 | 22 1/2 Sweep @ 4.09 | | 8 18 | 1 | 90° Elbow | 4 09 |
| 1/2 | Bag Cement @ 1.55 | | 39 | 1 | 1 x 6 Nipple | 65 |
| 1 | 1 x 6 Nipple | | 65 | 1 | Ton Loam | 3 50 |
| 2 | Hrs. Trucking @ 3.00 | | 6 00 | 1 | Ton hot top | 5 80 |
| | | | 135 96 | 1/2 | Lb. seed @ 1.11 | 28 |
| | PRO-RATED $\frac{135.87 \times 14.5 \text{ yrs}}{25}$ | | 78.73 | 6 1/2 | Hrs. Trucking @ 3.00 | 19 50 |
| McLaughlin | NEW HOUSE | | | 1 1/2 | Hrs. Shovel @ 6.50 | 9 75 |
| | 5' 4" PVC | | | 1 | Hr. Loader | 4. 00 |
| | 4x6 PVC TRAC FENCE | | | 1/2 | Hr. Roller & trailer | 3 50 |
| | | | | | | 206 23 |
| | | | | 2-16-68 | Sewer Block | |

DATE _____

TOWN OF LEXINGTON — BOARD OF PUBLIC WORKS

SEWER DIVISION

Sketch of Service Here

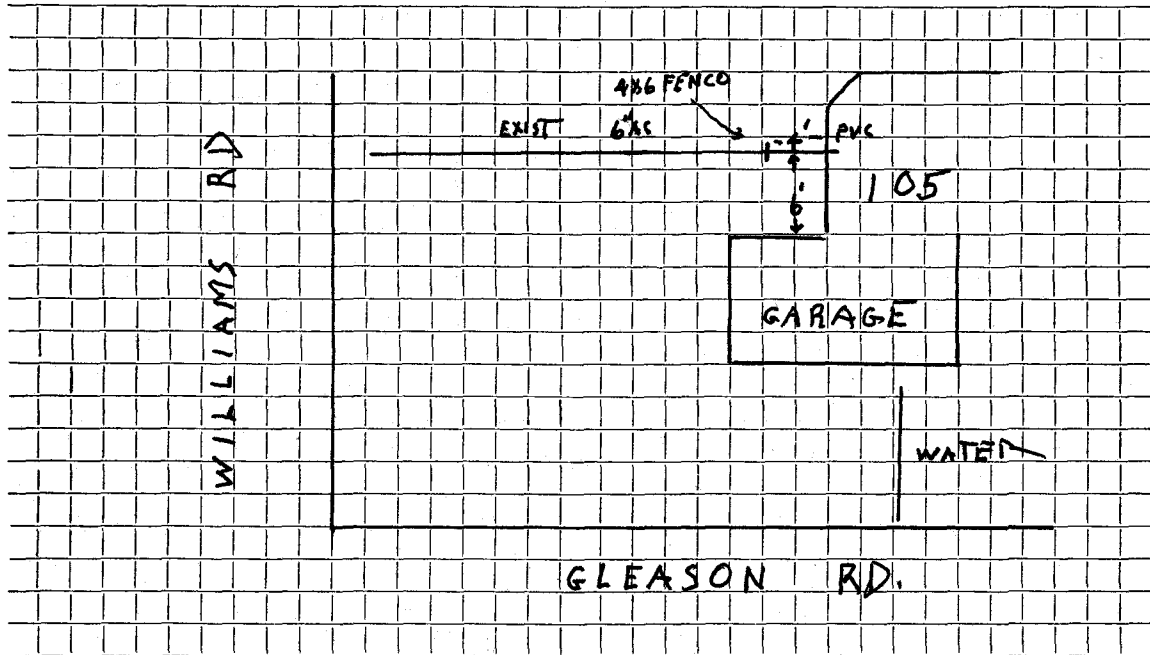

Connection made in Street. Work completed

Remarks: *Original Service 11-12-53*