

Name Robert H. Packard

Service No. 178

Address 14 Gleason Rd,

Lexington

Location

Kind of Pipe

Size

Size of Main

~~Repair~~ Renewal - New Service

COM. 11-23-53

Location

Date	Material	Amount	Total	Date	Amount
10/14/53	Labor	57 60		11-2-53 Deposited	125 00
	10% overhead	5 76	63 36	11-23-53 Refunded	(22 26)
	1/4" - 6" Sewer Pipe @ .3036		13 36		102 74
	1-6" Elbow		1 88		
	Joint Compound		2 64		
	4 Hr. Town Shovel @ 5.00		20 00		
	2 Hr. Trucking		1 50		
			102 74		
10-16-79	Renewal (Suburbanite #3432)				
	38' 4" Cast Iron - Rubber Joints				
	Labor				

TOWN OF LEXINGTON—DEPT. OF PUBLIC WORKS
SEWER DIVISION

DATE

NO.

The undersigned applies for the construction of a particular sewer connecting No.
Street and hereby agrees to comply with the Rules and Regulations governing the construction and use of Particular
Sewers, as now or at any future time established by the Board of Selectmen.


Am't of estimate \$.

Am't Paid \$.

..... Owner

Sketch of Service Here

14

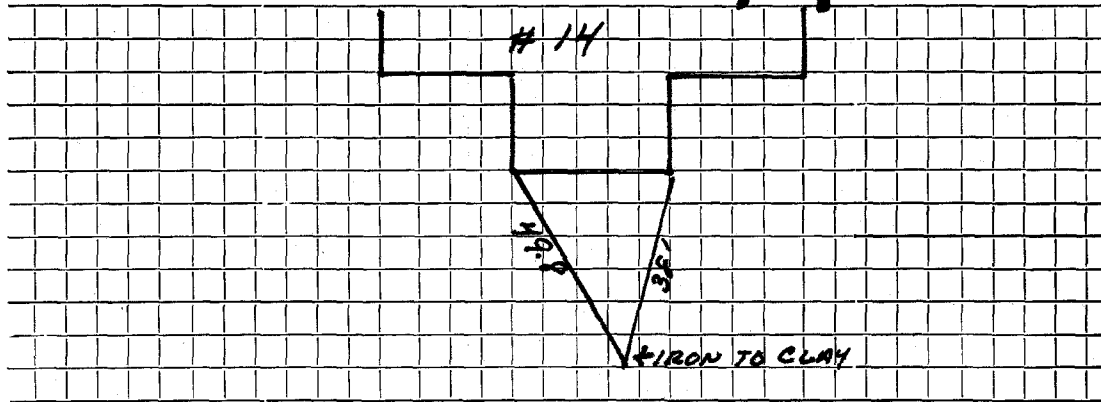

Connection made in Street.

Work completed 19..

Remarks: