

Name Emile Saulnier

Service No. 197

Address 21 Gleason Rd.

Lot 5
B/K 7

Lexington

Location

Kind of Pipe

Size

Size of Main

~~Repair~~ ~~Renewal~~ New Service

Com. 12-21-53

Location

Date	Material	Amount.	Total	Date	Amount
12/1/53	Labor	17 00		11-16-53	Deposited 125 00
	10% overhead	1 70	18 70	12-21-53	Paid a/c 1 26
	40' -6" Sewer pipe @.37		14 80	12-29-53	Paid (2 04)
	Joint Compound		2 40		128 30
	3 Hr. Littlefield shovel @7.50		22 50		
	2 Hr. Trucking		1 50		
			59 90		2.04 owing bill sent 12-21-53
	Plus attached card:		(68 40)	10-21-53	
	total charge:		128 30	30'	6" Sewer Pipe
				1 6"	Elbow
	Labor				

TOWN OF LEXINGTON—DEPT. OF PUBLIC WORKS
SEWER DIVISION

DATE


NO.

The undersigned applies for the construction of a particular sewer connecting No. Street and hereby agrees to comply with the Rules and Regulations governing the construction and use of Particular Sewers, as now or at any future time established by the Board of Selectmen.

Am't of estimate \$.....

Am't Paid \$.....

..... Owner

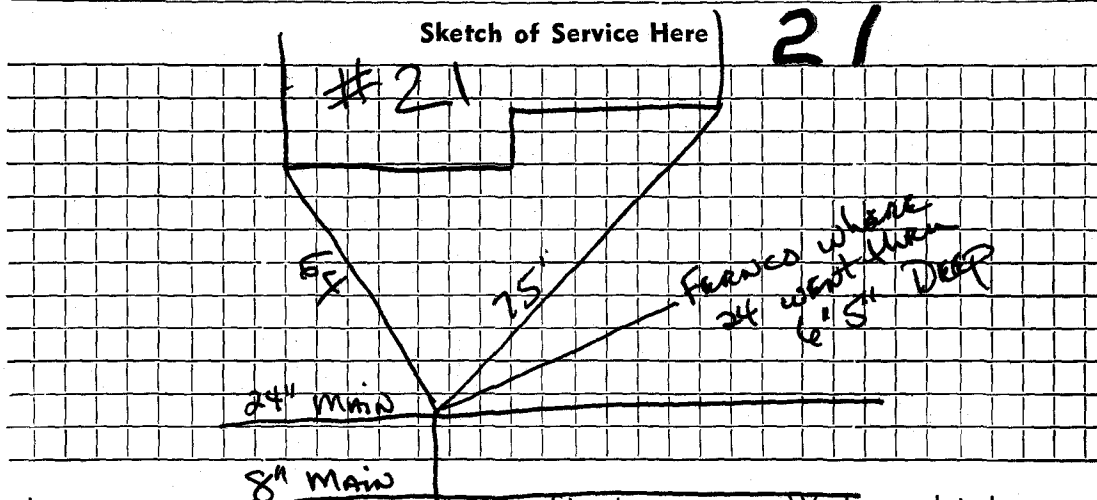

Connection made in Street. Work completed 19..

Remarks: