

Name Clifton A. Temple

Service No. 95

Address 31 Gleason Road

Location Comm. 9/30/57

Kind of Pipe

Size

Size of Main

~~Repair~~—Renewal—New Service

Location

Date	Material	Amount	Total	Date	Amount
7/29/57	Labor	88 39		7-22-57	Deposit \$ 150 00
7/30/57	"	58 32		12-24-57	Paid 75 36
		146 71			\$ 225 36
	10% overhead	14 67	161 38	10-21-53	
	48' -6" Transite Pipe @ .70		33 60	30' 6" Sewer Pipe	
	1 - 6" Transite Elbow		1 88		
	3 hrs. Town Shovel @ 6.50		19 50		
	4 hrs. Trucking @ .75		3 00		
	2 hrs. Hough Loader @ 3.00		6 00		
			225 36		
	Labor				
					Bill sent 10/4/57

# TOWN OF LEXINGTON—DEPT. OF PUBLIC WORKS

## SEWER DIVISION

DATE .....

NO. ....


The undersigned applies for the construction of a particular sewer connecting No. ....  
 Street and hereby agrees to comply with the Rules and Regulations governing the construction and use of Particular  
 Sewers, as now or at any future time established by the Board of Selectmen.

Am't of estimate \$. ....

Am't Paid \$. ....

..... Owner

**Sketch of Service Here**

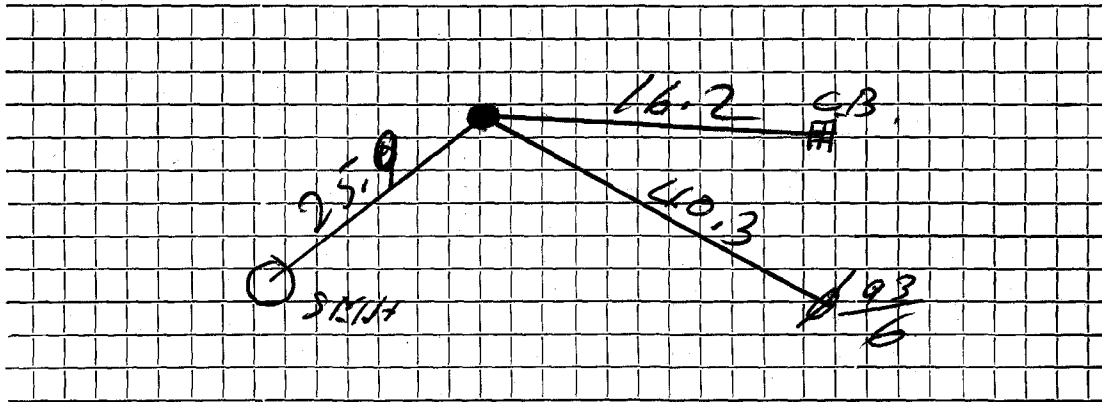

Connection made in ..... Street.

Work completed ..... 19..

Remarks: