

Name Ernest Outhet

Service No. 38

Address 34 Gleason Road

Location Comm. 10-8-56

Kind of Pipe

Size

Size of Main

Repair—Renewal—New Service

Location

Date		Material	Amount	Total	Date		Amount
5/22/56	Labor		28 60		4-30-56	Deposit	# 150 00
5/23/56	Labor		45 07		10-8-56	Refund	13 61
	10% overhead		7 37	81 04			136 39
	40' 6" Sewer Pipe @ .455			18 20	10-26-53		
	Joint Compound			2 40		16' 6" Sewer Pipe	
	4 hrs. Littlefield @ 8.50			34 00			
	1 hr. trucking @ .75			75			
				136 39			
	Labor				11-30-75	schids	
					4-9-87	Book with schedule	
					1-12-89	Papers in inventory of M.H.	
					12-22-97	PAPERS IN M.H.	

**TOWN OF LEXINGTON—DEPT. OF PUBLIC WORKS  
SEWER DIVISION**

DATE.....

NO. ....


The undersigned applies for the construction of a particular sewer connecting No.....  
Street and hereby agrees to comply with the Rules and Regulations governing the construction and use of Particular  
Sewers, as now or at any future time established by the Board of Selectmen.

Am't of estimate \$.....

Am't Paid \$.....

..... Owner

Sketch of Service Here **34**

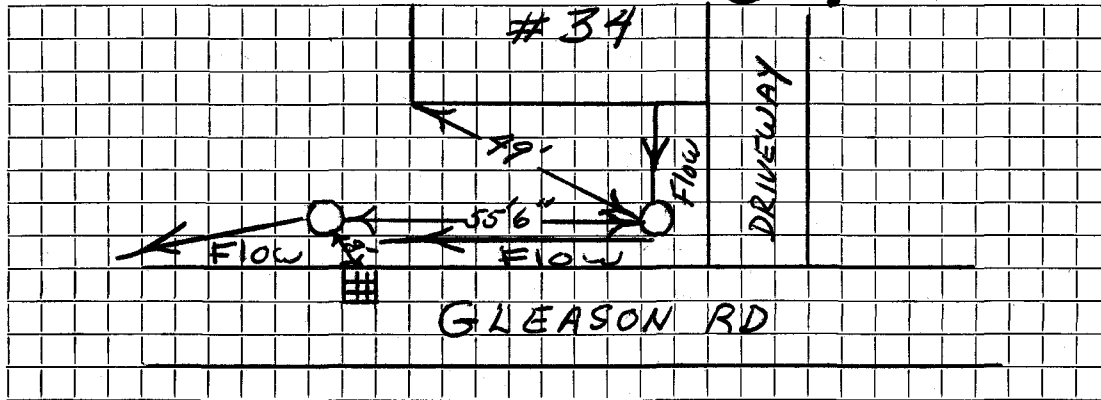

Connection made in..... Street.

Work completed.....19..

Remarks: