

Name Roland M. Wardrobe

Service No. 74

Address 43 Gleason Road

Lexington

Location

Kind of Pipe

Size

Size of Main

~~REPAIR RENEWAL~~ - New Service

COM. 6-8-53

Location

Date	Material	Amount	Total	Date		Amount
5/15/53	Labor	35 42		4-23-53	Deposited	150 00
	10% overhead	3 54	38 96	6-8-53	Refunded	(38 96)
	50'-6" sewer pipe @ .342		17 10			111 94
	1 - 6" elbow		1 88			
	joint compound		3 00			
	5 hrs. Littlefield shovel @ 7.50		37 50			
	2 hrs. trucking @ .75		1 50			
	patching 12 x 3		12 00			
			<u>111 94</u>			
	Labor					

TOWN OF LEXINGTON—DEPT. OF PUBLIC WORKS
SEWER DIVISION

DATE.....

NO.


The undersigned applies for the construction of a particular sewer connecting No.....
Street and hereby agrees to comply with the Rules and Regulations governing the construction and use of Particular
Sewers, as now or at any future time established by the Board of Selectmen.

Am't of estimate \$.....

Am't Paid \$.....

..... Owner

Sketch of Service Here

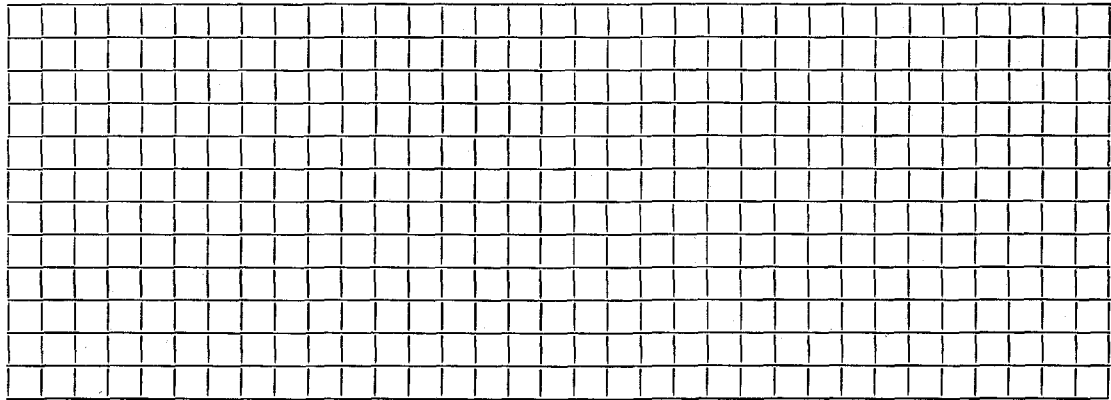

Connection made in..... Street.

Work completed.....19..

Remarks: