

Name Francis Dwyer

Service No. 51 1100

Address

Location 46 Gleason Road

Kind of Pipe

Size

Size of Main

~~Repair - Rework~~ - New Service

Location

Date	Material	Amount	Total	Date	Amount
10/25/47	Labor	52 40	52 40	10/22/47	120 00
	10% Overhead		5 24	12/31/47	13 94
	52' 6" Sewer Pipe @.26		13 52		106 06
	1 6" 1/4 Bend		1 28		
	2 hrs. Hired Shovel @ 7.00		14 00		
	2 hrs. Trucking		1 50		
	Joint Compound		3 12		
	Patching 15x3		15 00		
			106 06		
	Labor				
	Com 12/31/47				

TOWN OF LEXINGTON—DEPT. OF PUBLIC WORKS

SEWER DIVISION

DATE

NO.

The undersigned applies for the construction of a particular sewer connecting No. Street and hereby agrees to comply with the Rules and Regulations governing the construction and use of Particular Sewers, as now or at any future time established by the Board of Selectmen.


Am't of estimate \$.

Am't Paid \$.

..... Owner

Sketch of Service Here

46

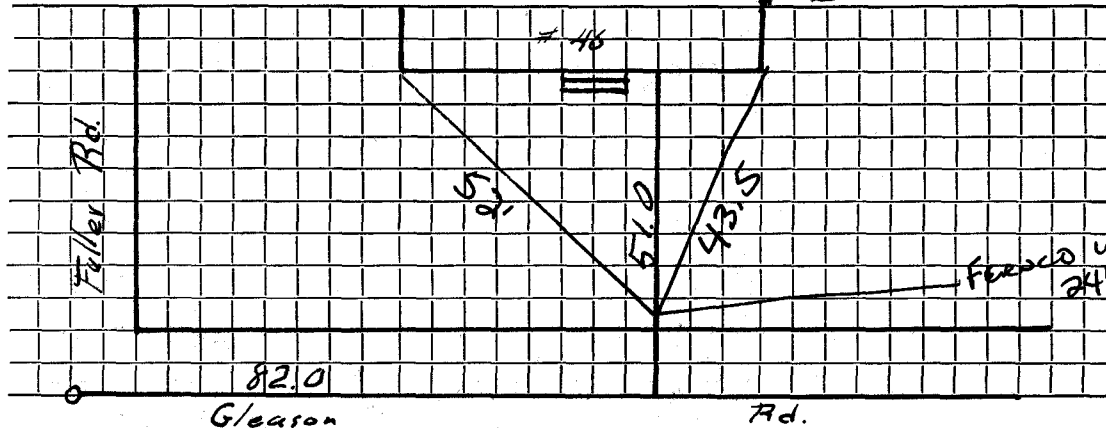

Feet 24" where went then 6' DEEP

Connection made in Street.

Work completed 19..

Remarks: