

Name **Vernon Jones**

Service No. **70 1119**

Address **51 Gleason Road**

Location **51 Gleason Road**

Kind of Pipe

Size

Size of Main

~~XXXXXXXXXX~~ **New Service**

Location

Date	Material	Amount	Total	Date	Amount
11/19/47	Labor	39 95		11/7/47	125 00
11/21/47	"	5 07	45 02	12/31/47	36 62
	10% Overhead		4 50		88 38
	48' 6" Sewer Pipe @ .26		12 48		
	Joint Compound		2 88		
	1 hr. Hired Shovel @ 7.00		7 00		
	2 hrs. Trucking		1 50		
	Patching 15x3		15 00		
			88 38		
	Labor				
	<i>Conv 12/31/47</i>				

TOWN OF LEXINGTON—DEPT. OF PUBLIC WORKS
SEWER DIVISION

DATE


NO.

The undersigned applies for the construction of a particular sewer connecting No.
Street and hereby agrees to comply with the Rules and Regulations governing the construction and use of Particular
Sewers, as now or at any future time established by the Board of Selectmen.

Am't of estimate \$.

Am't Paid \$.

..... Owner

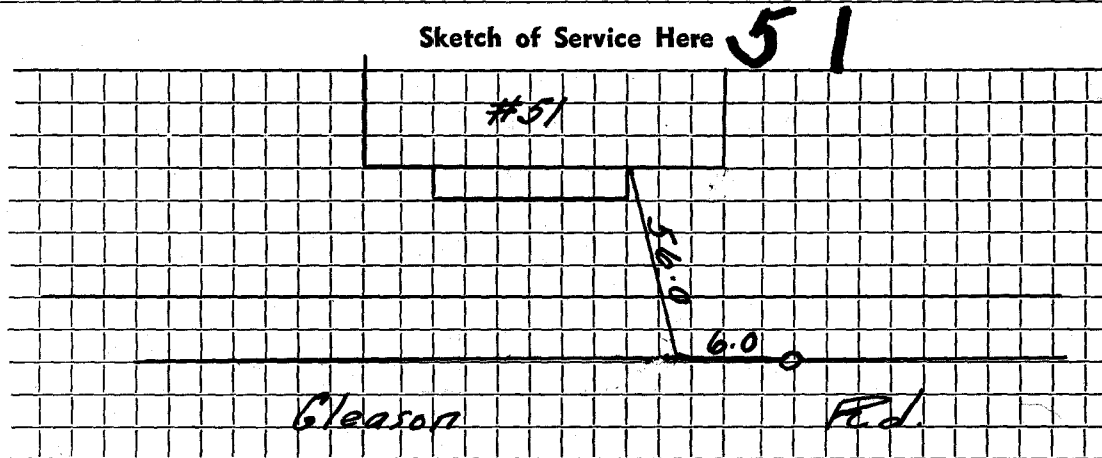

Connection made in Street.

Work completed 19..

Remarks: