

Name **Frederick Stevens**Service No. **9**Address **52 Gleason Road****Lexington**

Location

Kind of Pipe **COM. 4-28-52**

Size

Size of Main

~~Repair~~ ~~Renewal~~ **New Service**

Location

Date	Material	Amount	Total	Date	Amount
3/24/52	Labor	41 13	41 13	3-13-52	Deposited 125 00
	10% overhead		4 11	4-28-52	Refunded (9 64)
	40' - 6" sewer pipe @ .342		13 68		115 36
	1 - 6" -1/8 bend		1 54		
	joint compound		2 40		
	5 hrs. littlefield shovel @ 7.		35 00		
	2 hrs. trucking		1 50		
	patching 16 x 3		16 00		
			<u>115 36</u>		
	<b>Labor</b>				

TOWN OF LEXINGTON—DEPT. OF PUBLIC WORKS  
**SEWER DIVISION**

DATE .....

NO. ....

The undersigned applies for the construction of a particular sewer connecting No. ....  
Street and hereby agrees to comply with the Rules and Regulations governing the construction and use of Particular  
Sewers, as now or at any future time established by the Board of Selectmen.


Am't of estimate \$.....

Am't Paid \$.....

..... Owner

Sketch of Service Here

52

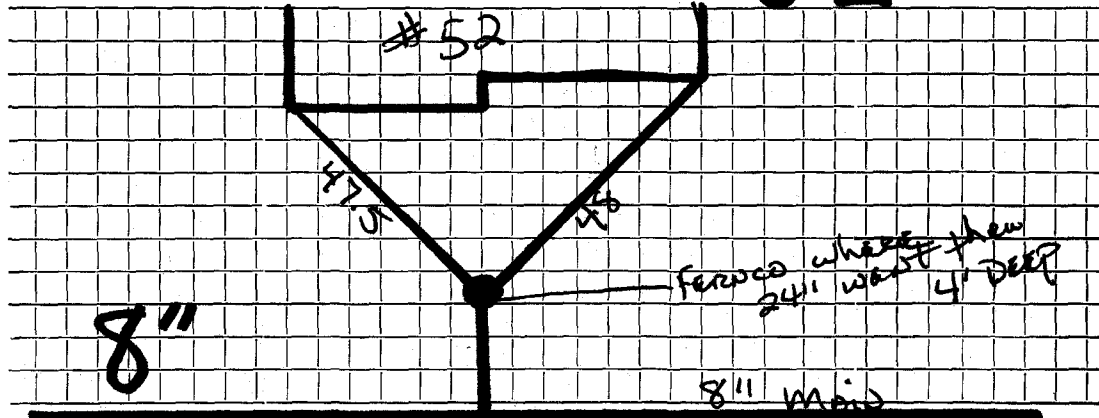

Connection made in ..... Street.

Work completed ..... 19..

Remarks: