

Name Daniel Murphy

Service No. 127

Address 54 Gleason Road

Location

Kind of Pipe

Size

Size of Main

~~Repair~~—Renewal—~~New Service~~ W.O. # 7053

Location APR 6 1970

Date	Material	Amount	Total	Date	Amount
11/13/69	Labor	57 99		11-29-69	175 00
12/10/69	"	12 17	70 16	4-4-70	57 58
	10% O.H.		7 02		117 42
	18' Transitepipe .88		15 84		<u>OUTSIDE</u>
	1 22o Sweep		5 09	11/13/69 XXXXXXXXXX	Labor 77 32
	6 Brick .07		42	12/10/69	" 20 09
	1/4 Bag cement 1.55		39	22'	Transite .88 19 36
	2 Hrs. shovel 6.50		13 00	1	Saddle 5 50
	1 " trucking		3 00	1	90o Elbow 5 09
	1/2 " compressor 5.00		2 50	1	12" Nipple 1 21
			117 42	10	Brick .07 70
				1/2	Bag cement 1.55 78
				1	Ton cold patch 5 85
				2	Hrs. shovel 4.00 8 00
				2	" trucking 3.00 6 00
				2 1/2	" " 1.50 75
				2 1/2	" roller 3.00 1 50
					trailer 2 00
					154 15


DATE _____

TOWN OF LEXINGTON — BOARD OF PUBLIC WORKS

SEWER DIVISION

Sketch of Service Here

54

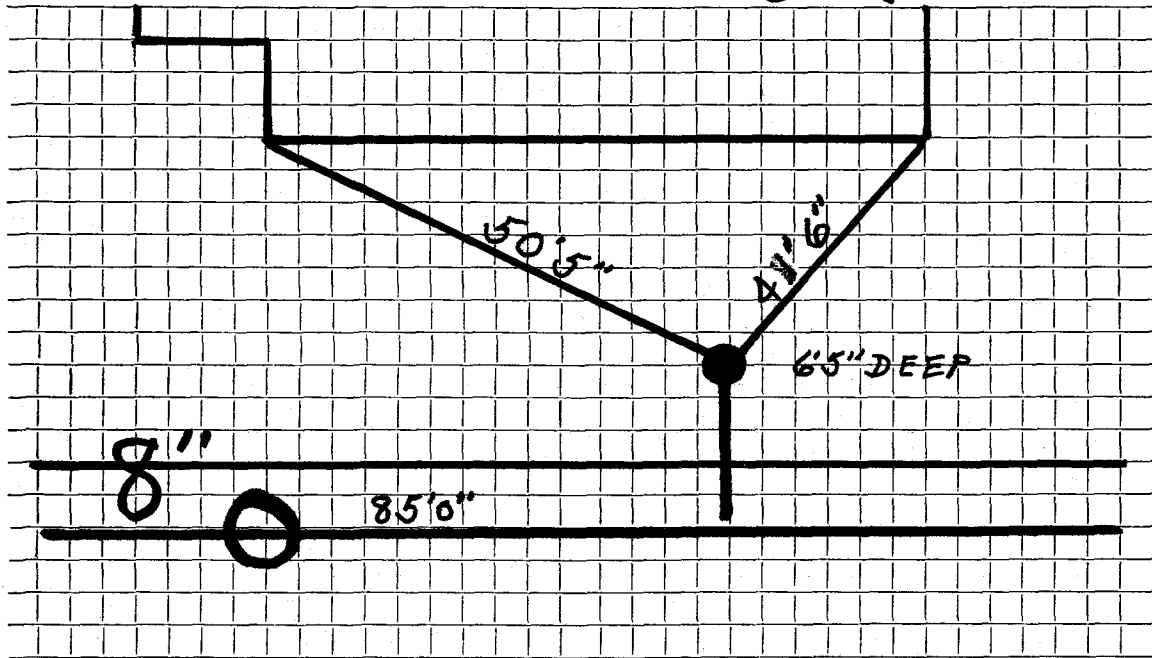

Connection made in Street. Work completed

Remarks: Original Service 11-24-47

.....
.....