

Name Abigail Smith

Service No. 82 1130

Address 55 Gleason Road

Location 55 Gleason Road

Kind of Pipe

Size

Size of Main

~~Repair/Renewal~~—New Service

Location

Date	Material	Amount	Total	Date	Amount
Nov. 25 '47	Labor	8 07		Nov. 19 47	150 00
26 '47		51 75		Dec. 31 47	24 42
28 47		7 60	67 42		125 58
	10% Overhead		6 74		
	56' 6" Sewer Pipe @ .26		14 56		
	Joint Compound		3 36		
	Hired Shovel 2 hrs. @ 7.00		14 00		
	Loader 1 hr.		3 00		
	Trucking 2 hrs. @ .75		1 50		
	Patching 15 x 3		15 00		
			125 58		
	Labor				
	<i>Com 12/31/47</i>				

TOWN OF LEXINGTON—DEPT. OF PUBLIC WORKS

SEWER DIVISION

DATE

NO.


The undersigned applies for the construction of a particular sewer connecting No. Street and hereby agrees to comply with the Rules and Regulations governing the construction and use of Particular Sewers, as now or at any future time established by the Board of Selectmen.

Am't of estimate \$.

Am't Paid \$.

..... Owner

Sketch of Service Here **55**

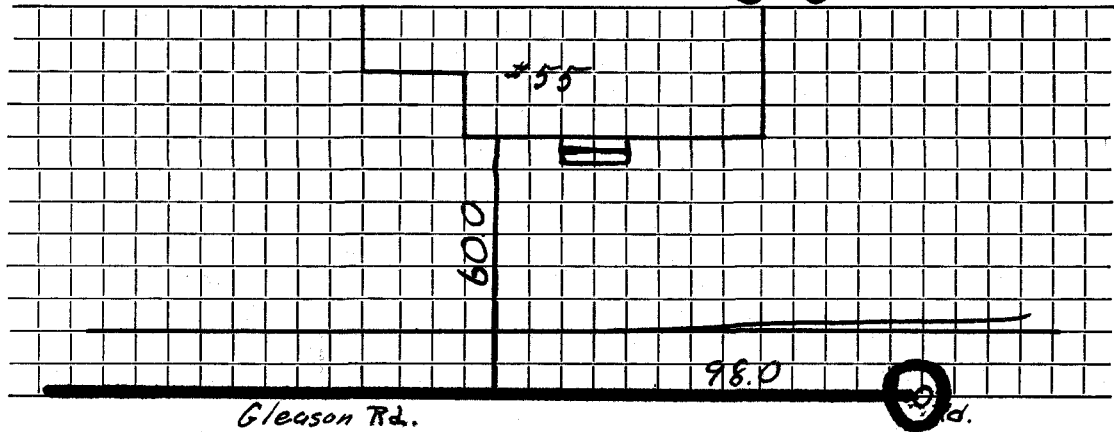

Connection made in Street.

Work completed 19..

Remarks: