

Name Raymond Barnes

Service No. 71

Address 59 Gleason Road

Location

Kind of Pipe

Size

Size of Main

~~Repair~~ Renewal ~~New Service~~ W.O. # 8129

Location JAN 17 1972

Date	Material	Amount	Total	Date	Amount
9/24/71	Labor		55 53	9-16-71	395 00
	10% O.H.		5 55	1-17-72	267 52
34'	6" Transite pipe .90		30 60		127 38
1	Donut		2 65		
1	1 1/2 E11		3 95	9/24/71	OUTSIDE Labor 74 04
2	Ton Cold patch 8.00		16 00	10/29/71	" 31 12
1	Hr. Shovel		6 50	20'	6" Transite pipe .90 18 00
1 1/2	Hr. Trucking 3.00		4 50	1	1 1/2 E11 3 95
1/2	Hr. Loader 5.00		2 50	1	90 E11 5 65
			127 78	1	6" Nipple 1 28
				2	Ron cold patch 8.00 16 00
				2 1/2	Hrs. shovel 4.00 10 00
				3	Hrs. Truck 3.00 9 00
				1	Hr. Loader 3 00
				1	Hr. Roller 2 00
					174 04


DATE _____

TOWN OF LEXINGTON — BOARD OF PUBLIC WORKS

SEWER DIVISION

Sketch of Service Here

59

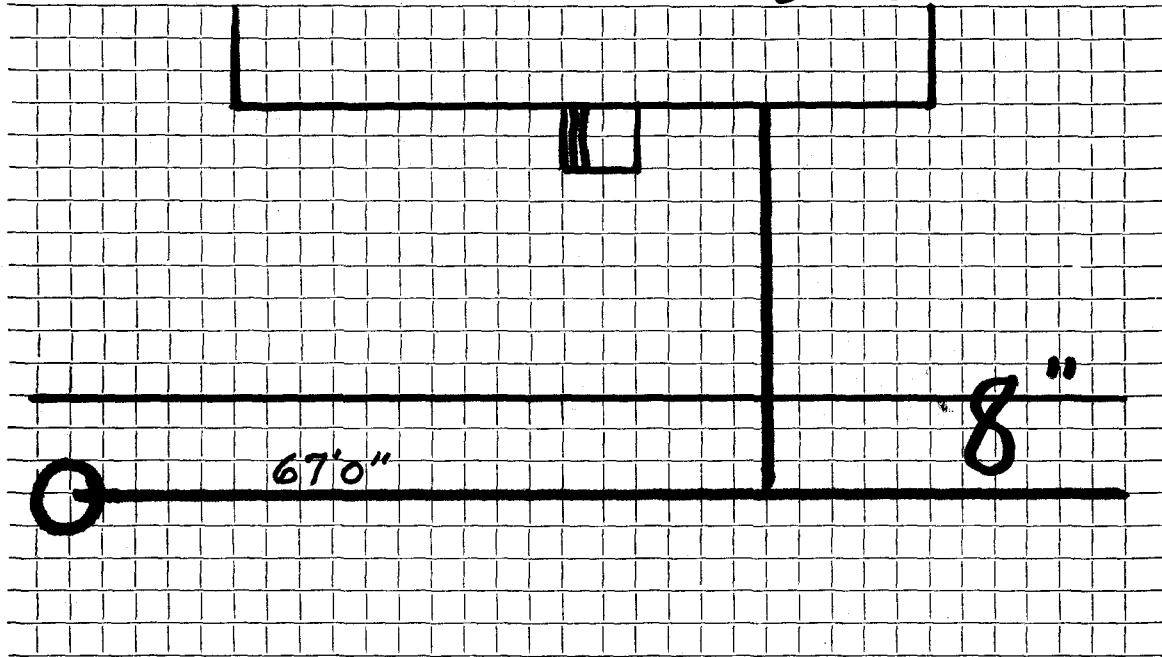

Connection made in Street. Work completed

Remarks: *Original Service 11-22-47*