

Name R. W. Cobham

Service No. 88 1136

Address 60

Location 60 Gleason Road

Kind of Pipe

Size

Size of Main

~~REPAIR WORK~~ - New Service

Location

Date	Material	Amount	Total	Date	Amount	
Dec. 4, '47	Labor	8 85		Nov. 28 47	Deposited	125 00
5,	"	50 40	59 25	Dec. 31 47	Refunded	50 4
	10% Overhead		5 93			119 96
	50' 6" Sewer Pipe @ .26		13 00			
	1 6" 1/8 Bend		1 28			
	Joint Compound		3 00			
	Hired Shovel 3 hrs. @ 7.00		21 00			
	Trucking 2 hrs. @ .75		1 50			
	Patching 15 x 3		15 00			
			119 96			
				8-3-64	S.B.	11 70
	Labor			3/31/8	Roots	
	Conv 12/31/47					

# TOWN OF LEXINGTON—DEPT. OF PUBLIC WORKS

## SEWER DIVISION

DATE .....

NO. ....

The undersigned applies for the construction of a particular sewer connecting No. .... Street and hereby agrees to comply with the Rules and Regulations governing the construction and use of Particular Sewers, as now or at any future time established by the Board of Selectmen.


Am't of estimate \$. ....

Am't Paid \$. ....

..... Owner

Sketch of Service Here

60

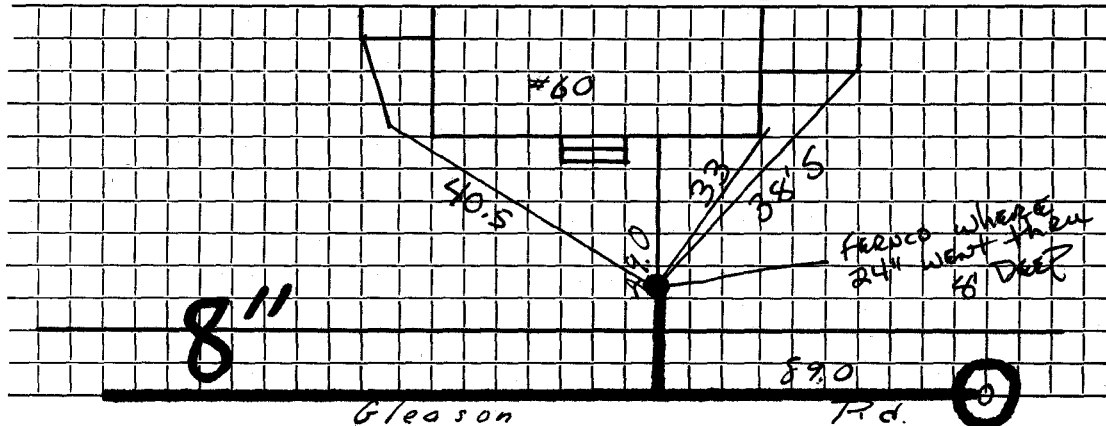

Connection made in ..... Street.

Work completed ..... 19..

Remarks: