




DATE 10-21-94

TOWN OF LEXINGTON — BOARD OF PUBLIC WORKS  
SEWER DIVISION

Sketch of Service Here

67

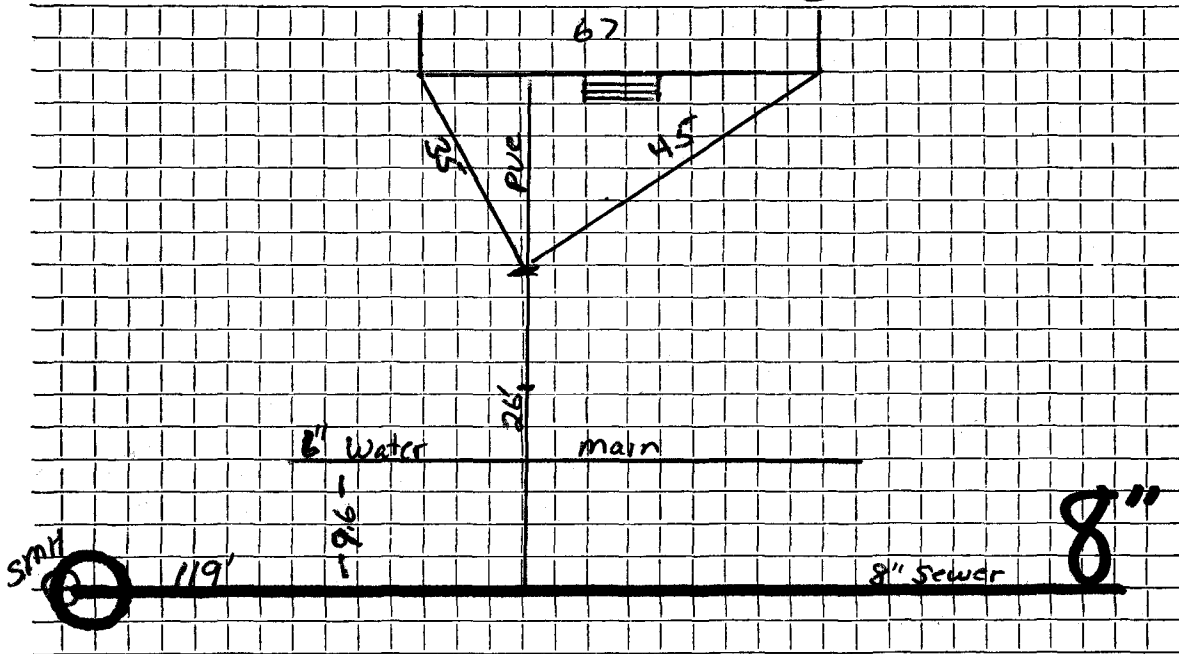

Connection made in ..... Street. Work completed .. 10-20-94 .....

Remarks: .....  
.....  
.....