

Name Paul West

Service No. 63

Address 70 Gleason Road

Lexington

Location 70 Gleason Road

Kind of Pipe

Size

Size of Main

Repair - Renewal - New Service

Com. 11-6-50

Location

Date	Material	Amount	Total	Date	Amount
Sept. 6 '50	Labor	17 20		Aug. 17 '50	100 -
	10% Overhead	1 72	18 92	Nov. 24 '50	3 58
	50' - 6" Sewer Pipe		14 00	March 31, 1952	3 90
	1 - 6" Elbow		1 56		
	Joint Compound		3 00		
	6½ hrs. Littlefield Shovel		45 50	Bell sent 11-15-50	
	2 hrs. Trucking		1 50		
	Patching 23 x 3		23 00		
			107 48	3/14/00	RENEWED
					2' OF 6" PVC
					1 4x6 FERNCO
	Labor				1 6x6 FERNCO

TOWN OF LEXINGTON—DEPT. OF PUBLIC WORKS
SEWER DIVISION

DATE

NO.

The undersigned applies for the construction of a particular sewer connecting No.
 Street and hereby agrees to comply with the Rules and Regulations governing the construction and use of Particular
 Sewers, as now or at any future time established by the Board of Selectmen.


Am't of estimate \$.

Am't Paid \$.

..... Owner

Sketch of Service Here

70

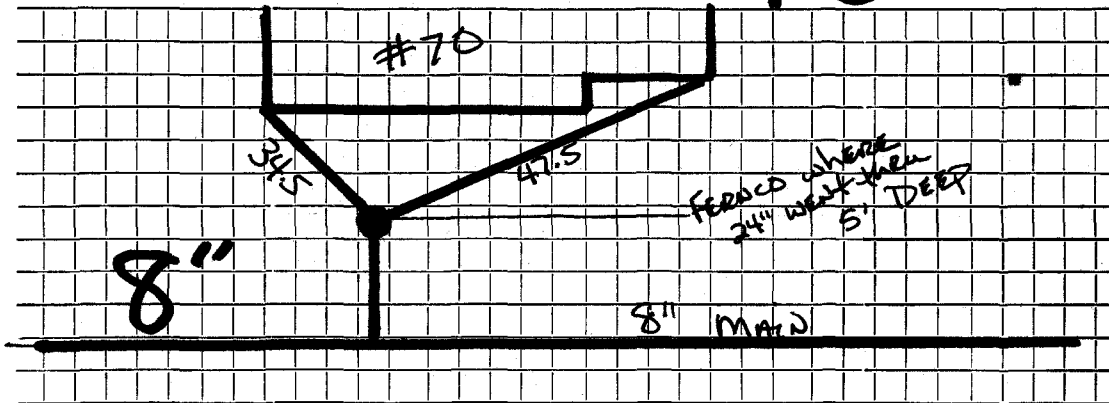

*FERROD WHERE
 24" WENT DOWN
 5' DEEP*

8" MAIN

Connection made in Street.

Work completed 19..

Remarks: