

Name Benjamin Nickerson

Service No. 68 1117

Address

Location 81 Gleason Road

Kind of Pipe

Size

Size of Main

~~Repair—Renewal—New Service~~

Location

Date	Material	Amount	Total	Date	Amount
11/1/47	Labor	53 23	53 23	11/7/47	115 00
	10% Overhead	5 32	5 32	12/31/47	3 01
	42' 6" Sewer Pipe		10 92		111 99
	Joint Compound		2 52		
	2½ Hrs. Hired Shovel @ 7.00		17 50		
	2 Hrs. Loader @ 3.00		6 00		
	2 hrs. Trucking		1 50		
	Patching		15 00		
			111 99		
	Labor				
	Com 12/31/47				

TOWN OF LEXINGTON—DEPT. OF PUBLIC WORKS
SEWER DIVISION

DATE

NO.

The undersigned applies for the construction of a particular sewer connecting No.
Street and hereby agrees to comply with the Rules and Regulations governing the construction and use of Particular
Sewers, as now or at any future time established by the Board of Selectmen.


Am't of estimate \$.....

Am't Paid \$.....

..... Owner

Sketch of Service Here

81

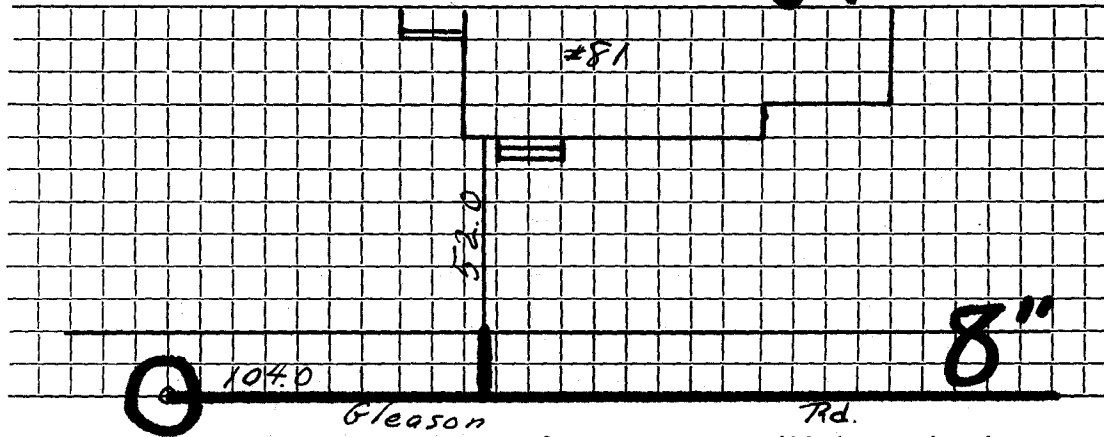

Connection made in Street.

Work completed 19..

Remarks: