

Name William H. Sullivan

Service No. 19

Address 82 Gleason Rd.

Lexington

Location

Kind of Pipe

COM. 4-28-52

Size

Size of Main

~~REPAIR WORK~~ New Service

Location

Date		Material	Amount	Total	Date	Amount
3/28/52	Labor		42 62	42 62	3-26-52	150 00
	10% overhead			4 26	4-28-52	14 38
	50' - 6" sewer pipe @ .342			17 10	"	4 14
	joint compound			3 00		131 48
	7 hrs. Littlefield shovel @ 7.			49 00		
	2 hrs. trucking			1 50		
	patching 14 x 3			14 00		
				131 48		
	Labor					

TOWN OF LEXINGTON—DEPT. OF PUBLIC WORKS
SEWER DIVISION

DATE

NO.

The undersigned applies for the construction of a particular sewer connecting No.
Street and hereby agrees to comply with the Rules and Regulations governing the construction and use of Particular
Sewers, as now or at any future time established by the Board of Selectmen.


Am't of estimate \$.....

Am't Paid \$.....

..... Owner

Sketch of Service Here

82

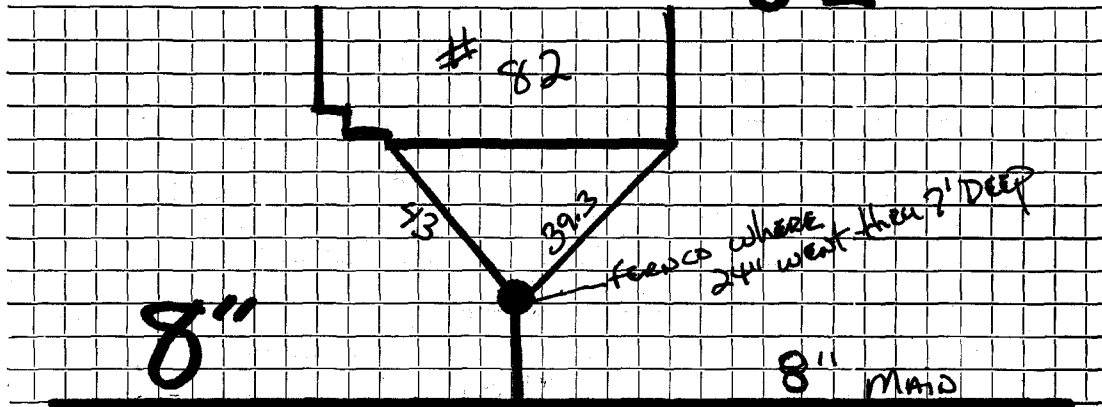

Connection made in Street.

Work completed 19..

Remarks: