

Name Donald Legro

Service No. 7

Address 84 Gleason Road

Lexington

Location

Kind of Pipe

Size

Size of Main

~~Repair Renewal~~ - New Service

Com. 3/30/53

Location

Date	Material	Amount	Total	Date	Amount
3/9/53	Labor	29 40		1-20-53	150 -
	10% overhead	2 94	32 34	3-30-53	36 00
	38' -6" sewer pipe @ .342		13 00		114 00
	1 -6" elbow		1 88		
	joint compound		2 28		
	7 hrs. Littlefield shovel @ 7.		49 00		
	2 hrs. trucking		1 50		
	patching 14 x 3		14 00		
			<u>114 00</u>		
	Labor			1/8/69	Salida

TOWN OF LEXINGTON—DEPT. OF PUBLIC WORKS

SEWER DIVISION

DATE.....

NO.


The undersigned applies for the construction of a particular sewer connecting No.....
 Street and hereby agrees to comply with the Rules and Regulations governing the construction and use of Particular
 Sewers, as now or at any future time established by the Board of Selectmen.

Am't of estimate \$.....

Am't Paid \$.....

..... Owner

Sketch of Service Here

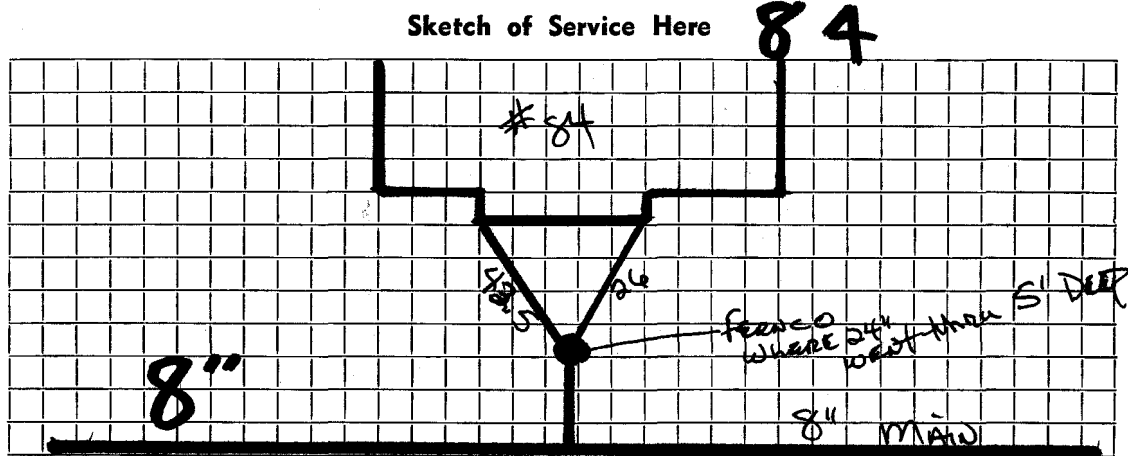

Connection made in..... Street.

Work completed.....19..

Remarks: