




DATE \_\_\_\_\_

TOWN OF LEXINGTON — BOARD OF PUBLIC WORKS

SEWER DIVISION

Sketch of Service Here **86**

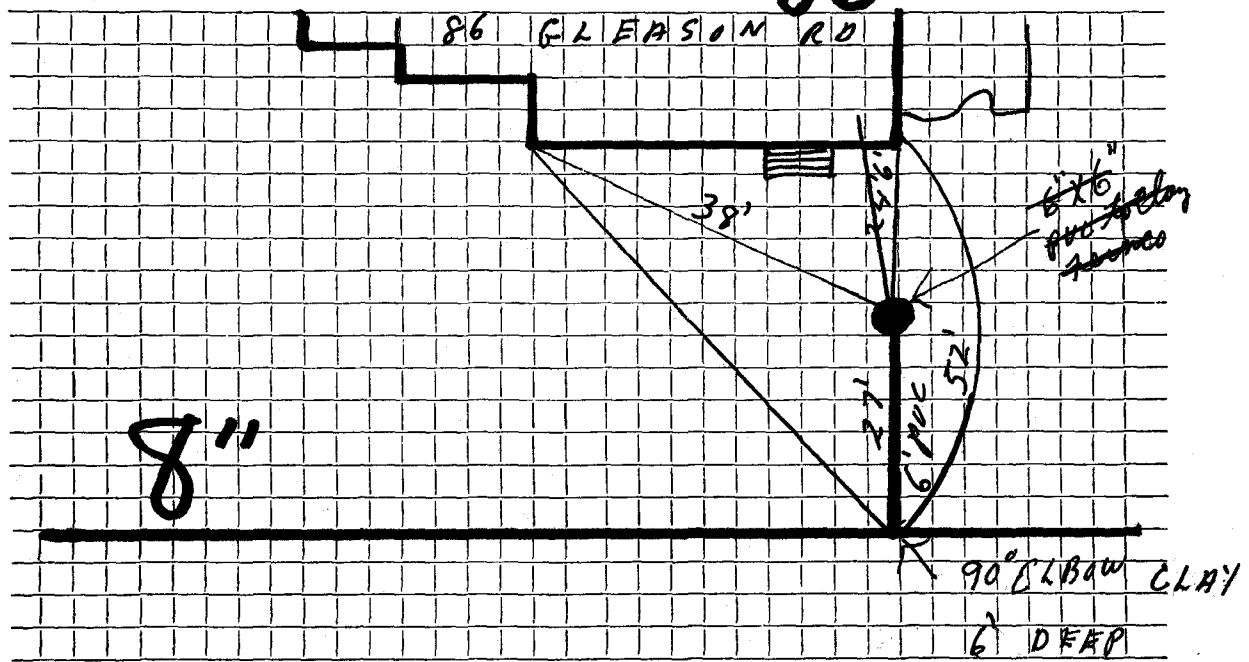

Connection made in GLEASON RD ..... Street. Work completed JUNE 5, 1985.....

Remarks: .....  
.....  
.....